

MAR 17 2000

LAND CORNER RECORDATION CERTIFICATE
Filing Requirement of Act 74, Mich. P.A. 1970

SECTION

For corners in


MACOMB (County) Located In: MACOMB TWP. Corner Code # H-9
1. Public Land Survey T 3N R 13E
2. Property Controlling in Section S T R
3. Miscellaneous Property in Sec. S T R
4. Lot No. Recorded Plat
5. Private Claims

1091829
LIBER 9268 PAGE 17
12/27/1999 01:15:42 P.M.
MACOMB COUNTY, MI
CARMELLA SABAUGH, REG/DEEDS

Register of Deeds Stamp & File Number

I, GEORGE M. PLATZ, in a field survey on APRIL 19, 1999, do hereby state that under requirements of P.A. 74, Michigan P.A. of 1970, the corner points mentioned in lines 1 and 2 above were in conformance with regulations and rules therefore as required in the current manual of survey instructions of the United States Department of the Interior, Bureau of Land Management or by a decree of a Court of Law and/or that the corner points mentioned in lines 3, 4 and 5 above were in conformance with the rules of the Michigan Board of Land Surveyors or by a Decree of a Court of Law; established, re-established, monumented, recovered, found as expressed below:

NOTE: Not more than 2 corners, all in the same town and range, may be recorded on this certificate.

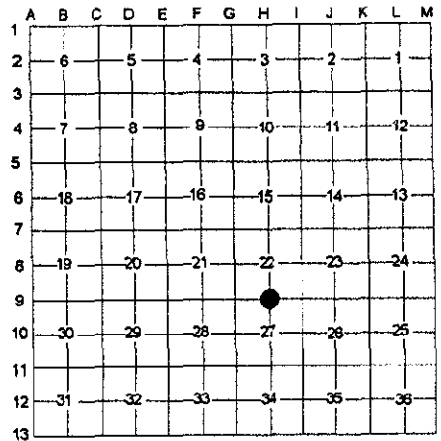

A. Description of original monument and accessories and/or subsequent restoration:

Table with 6 columns: Year, Description, Monument Type, Name, License #, Notes. Includes entries for 1817 (Set post), 1973 (1/2 inch Pipe), 1989 (1/2 inch Rod), 1992 (1/2 inch Pipe), 1994 (3/4 inch Rod w / MCRC Remon cap), and 1997 (3/4 inch Rod w / MCRC Remon cap).

B. Description of corner evidence found and/or method applied in restoring or reestablishing corner:

The remonumentation point set in 1994 has been destroyed by road construction. Found PK nail in the centerline of the existing asphalt pavement of 22 Mile Road - 2 remaining witness ties from LCRC L7361 P634 along with field measurements to adjacent corners verified its position. The position of this point has been used in the following subdivisions:

Table listing subdivisions: Deerfield Park No. 1 (L.114 P.43-49), Deerfield Park No. 2 (L.117 P.28-33), Deerfield Farms (L.130 P.37-41), Deerfield Park East (L.128 P.12-15), Cornerstone Village No. 1 (L.133 P.37-46), Cornerstone Village No. 2 (L.134 P.14-18).

Table listing field measurements to adjacent corners: G-9 to H-9 (2670.23' (M), 2670.25' (R), 2670.24' (R)), H-9 to I-9 (2684.50' (M), 2684.40' (R), 2684.50' (R), 2684.54' (R)).

ACCEPTED BY THE MACOMB COUNTY SURVEY PEER GROUP AS THE OFFICIAL CORNER UNDER MICHIGAN PUBLIC ACT 345 OF 1990 AT A MEETING HELD ON 10/26/99. WILLIAM E. SODERBERG, P.S., CHAIRMAN

C. Description of monument for corner and accessories established to perpetuate locating the position of the corner:


I replaced the found PK nail with a 3/4 inch x 24 inch iron rod with 2 inch diameter aluminum cap stamped 'Macomb County Monument MI Act 345 #38121' in a new monument box and witnessed it as follows:

Table listing monument details: Az. 24 degrees (60.76'), Az. 65 degrees (127.49'), Az. 125 degrees (87.55'), Az. 205 degrees (53.56').

The selected location is accepted by me and generally accepted by Professional Surveyors as the best available evidence of the position of the original corner.

Signed by George M. Platz Date

Surveyor's Michigan License No. 38121

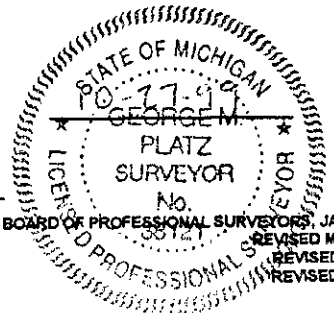

Handwritten number 951