

LAND CORNER RECORDATION CERTIFICATE
Filing Requirement of Act 74, Mich. P.A. 1970

For corners in

Macomb
 (County)


Located In: Macomb Twp. Corner Code #

SURVEY &
 REMONUMENTATION

MAR 15 1999

SECTION

1. Public Land Survey T-3-N R-13-E I-2
 T _____ R _____
 T _____ R _____
 T _____ R _____
 2. Property Controlling in Section S _____ T _____ R _____
 S _____ T _____ R _____
 3. Miscellaneous Property in Sec. S _____ T _____ R _____
 S _____ T _____ R _____

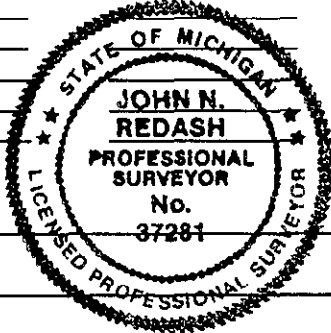

Register of Deeds Stamp & File Number

4. Lot No. _____, Recorded Plat _____
 5. Private Claims _____

	A	B	C	D	E	F	G	H	I	J	K	L	M
1													
2	6		5		4		3		2		1		
3													
4	7		8		9		10		11		12		
5													
6	18		17		16		15		14		13		
7													
8	19		20		21		22		23		24		
9													
10	30		29		28		27		26		25		
11													
12	31		32		33		34		35		36		
13													

I, John N. Redash, in a field survey on Jan. 6, 1998 do hereby state that under requirements of P.A. 74, Michigan P.A. of 1970, the corner points mentioned in lines 1 and 2 above were in conformance with regulations and rules therefore as required in the current manual of survey instructions of the United States Department of the Interior, Bureau of Land Management or by a decree of a Court of Law and /or that the corner points mentioned in lines 3, 4 and 5 above were in conformance with the rules of the Michigan Board of Land Surveyors or by a Decree of a Court of Law; established, re-established, monumented, recovered, found as expressed below:

NOTE: Not more than 2 corners, all in the same town and range, may be recorded on this certificate.

A. Description of original monument and accessories and/or subsequent restoration:

1817	7" Dia. Beech	G.L.O. Notes	W. Preston	N/A	N/A
1975	Found 5/8" Iron	Survey	G. Avendt	#16034	L2605, P593
1975	Found 5/8" iron	L.C.R.C.	G. Avendt	#16034	L2605, P594
1979	5/8" Iron bar	Survey	H. Kobs	#14097	L3217, P698
1979	5/8" Iron bar	L.C.R.C.	H. Kobs	#14097	L3186, P870
1979	5/8" Iron Bar	Survey	H. Kobs	#14097	L3186, P879

B. Description of corner evidence found and/or method applied in restoring or reestablishing corner:

A 5/8" iron in an existing monument box in asphalt pavement currently occupies this corner. The following witness ties were used to recover and verify its position: 1 tie matches current measurements from L.C.R.C. L2605, P594, and L3186 P870. Field measurements were obtained between the following corners:

I-1 to I-2		I-2 to I-3	
2724.02' Meas.		2681.69' Meas.	
2673.00' G.L.O.		2640.00' G.L.O.	
2723.63' Rec. Survey L3186, P879		2681.81' Rec. Tax Descriptions	
2723.67' Rec. Tax Descriptions			

ACCEPTED BY THE MACOMB COUNTY SURVEY PEER GROUP AS THE OFFICIAL CORNER UNDER MICHIGAN PUBLIC ACT 345 OF 1990 AT A MEETING HELD ON 10/13/98

 WILLIAM E. SODERBERG, P.S., CHAIRMAN

C. Description of monument for corner and accessories established to perpetuate locating the position of the corner:

I replaced the found 5/8" iron in an existing monument box with a 3/4" X 24" iron rod with a 2" aluminum cap stamped "Macomb County Monument MI Act 345 #37281". Witnesses are as follows:

AZ. 20° 86.94'	Set "X" in S. end 12" CMP
AZ. 91° 24.22'	Set mag nail and Macomb County Remon. tag in N. face u-pole
AZ. 278° 37.82'	Set mag nail and Macomb County Remon. tag in N. face u-pole
AZ. 90° 33.09'	Found capped iron #30103
AZ. 340° 55.84'	Set "X" in N. end 12" CMP

The selected location is accepted by me and generally accepted by Professional Surveyors as the best available evidence of the position of the original corner.

Signed by John N. Redash
 Surveyor's Michigan License No. 37281

Date 12-23-98

FORM APPROVED BY MICHIGAN STATE BOARD OF PROFESSIONAL SURVEYORS, JAN. 28, 1971
 REVISED MAY 14, 1975
 REVISED JAN., 1983
 REVISED OCT., 1996

823