

**LAND CORNER RECORDATION CERTIFICATE**  
**Filing Requirement of Act 74, Mich. P.A. 1970**

For corners in


Macomb Located In: Macomb Twp. Corner Code #  
 (County)

SURVEY &  
 REMONUMENTATION

MAR 15 1999

SECTION

1. Public Land Survey T-3-N R-13-E I-4  
 T R  
 T R  
 T R
2. Property Controlling in Section S T R  
 S T R  
 S T R
3. Miscellaneous Property in Sec. S T R  
 S T R
4. Lot No. \_\_\_\_\_, Recorded Plat \_\_\_\_\_
5. Private Claims \_\_\_\_\_

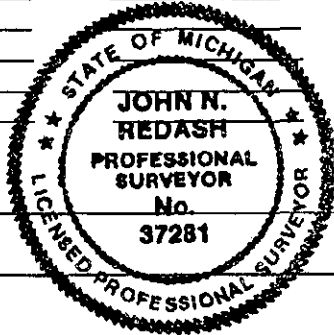

Register of Deeds Stamp & File Number

I, John N. Redash, in a field survey on Jan. 6, 1998 do hereby state that under requirements of P.A. 74, Michigan P.A. of 1970, the corner points mentioned in lines 1 and 2 above were in conformance with regulations and rules therefore as required in the current manual of survey instructions of the United States Department of the Interior, Bureau of Land Management or by a decree of a Court of Law and for that the corner points mentioned in lines 3, 4 and 5 above were in conformance with the rules of the Michigan Board of Land Surveyors or by a Decree of a Court of Law; established, re-established, monumented, recovered, found as expressed below:

	A	B	C	D	E	F	G	H	I	J	K	L	M
1													
2	6	5		4	3		2		1				
3													
4	7	8		9	10		11		12				
5													
6	18	17		16	15		14		13				
7													
8	19	20		21	22		23		24				
9													
10	30	29		28	27		26		25				
11													
12	31	32		33	34		35		36				
13													

NOTE: Not more than 2 corners, all in the same town and range, may be recorded on this certificate.

A. Description of original monument and accessories and/or subsequent restoration:

1817	Set post	G.L.O. Notes	W. Preston	N/A	N/A
1973	Found 1" bar	L.C.R.C.	H. Avey	#15396	L2426, P339
1980	Found 1/2" iron	Survey	G. Avendt	#16034	L3242, P633
1993	Found 1/2" iron w/cap #30103	L.C.R.C.	D. King	#30085	L5778, P411
1995	Found 1/2" bar #30103	L.C.R.C.	J. Wright	#40165	L6832, P274

B. Description of corner evidence found and/or method applied in restoring or reestablishing corner:

A 1/2" iron rod with Cap #30103 currently occupies this corner located 150' ± - south of a river on Card Road. The following witness ties were used to recover and verify its position: Three ties match current measurements from L.C.R.C.s L5778, P411 and L6832, P274. Field measurements were observed between the following corners:

I-3 to I-4		I-4 to I-5	
2665.88	Meas.	2685.17	Meas.
2640.00	G.L.O.	2640.00	G.L.O.
2665.97	Rec. Tax Desc.	2685.24	Rec. Tax Desc.

ACCEPTED BY THE MACOMB COUNTY SURVEY PEER GROUP AS THE OFFICIAL CORNER UNDER MICHIGAN PUBLIC ACT 345 OF 1990 AT A MEETING HELD ON 10/13/98

William E. Soderberg  
 WILLIAM E. SODERBERG, P.S., CHAIRMAN

C. Description of monument for corner and accessories established to perpetuate locating the position of the corner:

I replaced the 1/2" iron rod with a 3/4" X 24" iron rod with a 2" aluminum cap stamped "Macomb County Monument MI Act 345 #37281". Witnesses are as follows:

AZ. 70°	22.04'	Set mag. nail with Macomb County Remon tag in S. face 18" Ash
AZ. 110°	27.35'	Set mag. nail with Macomb County Remon. tag in N. face 38" Sycamore
AZ. 316°	11.08'	Found P.K. nail N.E. face wood fence post
AZ. 357°	46.61'	Set mag. nail and Macomb County Remon. tag in N.W. face of 10" Ash
AZ. 221°	75.71'	Set mag. nail and Macomb County Remon. tag in N.W. face of 10" Ash

The selected location is accepted by me and generally accepted by Professional Surveyors as the best available evidence of the position of the original corner.

Signed by John N. Redash Date 12-23-98  
 Surveyor's Michigan License No. 37281

FORM APPROVED BY MICHIGAN STATE BOARD OF PROFESSIONAL SURVEYORS, JAN. 28, 1971  
 REVISED MAY 14, 1975  
 REVISED JAN., 1983  
 REVISED OCT., 1995

825