

SURVEY & REMONUMENTATION

APR 28 1995

COMMISSION

LAND CORNER RECORDATION CERTIFICATE Filing Requirement of Act 74, Mich. P.A. 1970 Macomb Twp.

For corners in Macomb

94 DEC -9 PM 2: 50
CARMEL J. SABAUGH
REGISTER OF DEEDS
MACOMB COUNTY, MI

		Located In:		Corner Code #:	
(County)		3N	13E	I-6	
1. Public Land Survey		T _____	R _____		_____
		T _____	R _____		_____
		T _____	R _____		_____
		T _____	R _____		_____
2. Property Controlling in Section	S _____	T _____	R _____		_____
	S _____	T _____	R _____		_____
3. Miscellaneous Property in Sec.	S _____	T _____	R _____		_____
	S _____	T _____	R _____		_____

C150796

LIBER 6523 PAGE 943

Register of Deeds Stamp & File Number


4. Lot No. _____, Recorded Plat _____
5. Private Claims _____

Robert D. Kohn

August 8

94

I, _____, in a field survey on _____, 19_____, do hereby certify that under requirements of P.A. 74, Michigan P.A. of 1970, the corner points mentioned in lines 1 and 2 above were in conformance with regulations and rules therefore as required in the current manual of survey instructions of the United States Department of the Interior, Bureau of Land Management or by a decree of a Court of Law and/or that the corner points mentioned in lines 3, 4 and 5 above were in conformance with the rules of the Michigan Board of Land Surveyors or by a Decree of a Court of Law; established, re-established, monumented, re-monumented, recovered, found as expressed below:

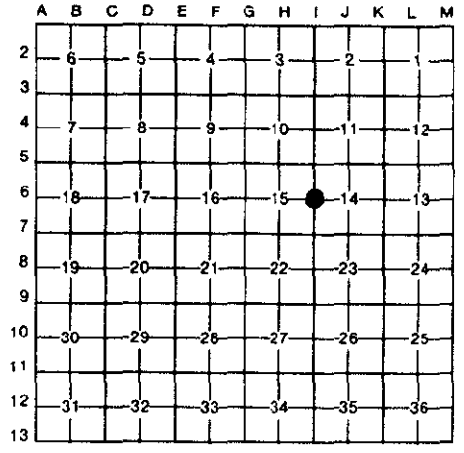

NOTE: Not more than 4 corners, all in the same town and range, may be recorded on this certificate.

A. Description of original monument and accessories and/or subsequent restoration:

1817	3" Ironwood	G.L.O.	W. Preston	N/A	Notes
1980	1/2" Iron bar	L.C.R.C.	H. Kobs	#14097	L3217 P668
1980	1/2" Iron bar	Survey	H. Kobs	#14097	L3217 P703

B. Description of corner evidence found and/or method applied in restoring or reestablishing corner:

A 1/2" iron rod in asphalt pavement currently marks this corner. The following witness ties were used to recover and verify its position.
2 ties from L.C.R.C. L3217 P668

Field measurements were made between the following corners:

I-5 to I-6	2665.78	meas.			
	2640	G.L.O.	Notes		
	2665.64	rec.	L3217 P703 through calculation	Survey	
	2665.79	rec.	A.E.W. Section break down		
I-6 to I-7	2669.58	meas.			
	2640	G.L.O.	Notes		
	2668.78	rec.	A.E.W. section breakdown		


ACCEPTED BY THE MACOMB COUNTY SURVEY FEE GROUP AS THE OFFICIAL CORNER UNDER MICHIGAN PUBLIC ACT 345 OF 1990 AT A MEETING HELD ON 9-27-94
William E. Soderberg
WILLIAM E. SODERBERG, P.S., CHAIRMAN

C. Description of monument for corner and accessories established to perpetuate locating the position of the corner:

I replaced the 1/2" iron rod with a 3/4" x 24" iron rod with 2" diameter aluminum cap stamped "Macomb County Monument MI Act 345 #26459" in a new monument box.

S.88° E.	91.87'	Set P.K. nail and remon. tag in S. face of a 30" tree
S.49° E.	45.16	S. face of gas marker post #16
S.17° W.	116.84'	E. face of gas marker post
N.57° W.	37.31'	Wood post

The selected location is accepted by me and generally accepted by Professional Surveyors as the best available evidence of the position of the original corner.

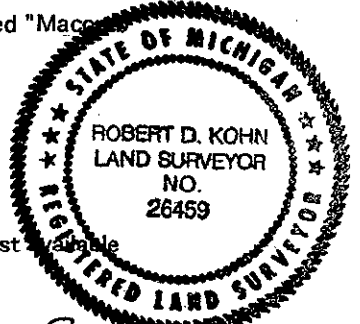

Signed by Robert D. Kohn
Surveyor's Michigan License No. 26459

Date NOVEMBER 9, 1994