SURVEY &
REMONUMENTATION

APR 28 1995

COMMISSION

LAND CORNER RECORDATION CERTIFICATE

Filing Requirement of Act 74, Mich. P.A. 1970

94 DEC -9 PM 2:50

CARMELLA SABAUGH
REGISTER OF DEEDS
MACOMB COUNTY, MI

LIBER 6523 PAGE 944
C150797

Register of Deeds Stamp & File Number

For corners in Macomb (County)

Macomb Twp.

	Located In:		Corner Code #
	3N	13E	I-7
1. Public Land Survey	T ____	R ____	_____
	T ____	R ____	_____
	T ____	R ____	_____
	T ____	R ____	_____
2. Property Controlling	S ____ T ____	R ____	_____
in Section	S ____ T ____	R ____	_____
3. Miscellaneous	S ____ T ____	R ____	_____
Property in Sec.	S ____ T ____	R ____	_____

4. Lot No. _____ , Recorded Plat _____
5. Private Claims _____

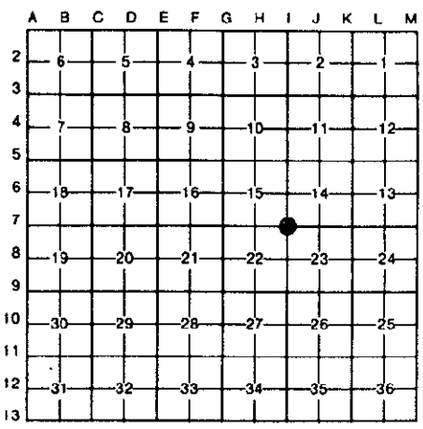

Robert D. Kohn July 26 94

I, _____ , in a field survey on _____ , 19 _____ , do hereby certify that under requirements of P.A. 74, Michigan P.A. of 1970, the corner points mentioned in lines 1 and 2 above were in conformance with regulations and rules therefore as required in the current manual of survey instructions of the United States Department of the Interior, Bureau of Land Management or by a decree of a Court of Law and/or that the corner points mentioned in lines 3, 4 and 5 above were in conformance with the rules of the Michigan Board of Land Surveyors or by a Decree of a Court of Law; established, re-established, monumented, re-monumented, recovered, found as expressed below:

NOTE: Not more than 4 corners, all in the same town and range, may be recorded on this certificate.

A. Description of original monument and accessories and/or subsequent restoration:

1817	Post	G.L.O.	W. Preston	N/A	Notes
1949	3/4" Iron	M.C.R.C.	N/A	N/A	File 83
1954	3/4" Iron in asphalt	M.C.R.C.	N/A	N/A	File 83
1982	Iron in mon. box	Survey	R. Smith	#16052	L3461 P312
1994	Rod in hand hole	Survey	S. Young	#25885	L6415 P66

B. Description of corner evidence found and/or method applied in restoring or reestablishing corner:

A 1/2" iron rod in a monument box in asphalt pavement currently marks the location of this corner. No L.C.R.C. on file. No accessories existing from M.C.R.C. witnesses. Matched 2 witness ties from survey L3461 P312.

Field measurements were made between the following corners:

I-7 to I-6	2669.58	meas.		
	2640.00	rec.	G.L.O.	
I-7 to H-7	2666.19	meas.		
	2666.23	rec.	A.E.W. Section breakdown	Survey
	2634.72	rec.	G.L.O.	
I-7 to I-8	2683.85	meas.		
	2640.00	rec.	G.L.O.	
	2683.83	rec.	L6415 P66	Survey
	2683.73	rec.	A.E.W. Section breakdown	Survey

ACCEPTED BY THE MACOMB COUNTY SURVEY PEE
GROUP AS THE OFFICIAL CORNER UNDER MICHIGA
PUBLIC ACT 345 OF 1990 AT A MEETING HEI
ON 9-27-94
William E. Soderberg
WILLIAM E. SODERBERG, P.S., CHAIRMAN

C. Description of monument for corner and accessories established to perpetuate locating the position of the corner:

I replaced the 1/2" iron rod with a 3/4" x 24" iron rod with 2" diameter aluminum cap stamped "Macomb County Monument MI Act 345 #26459" in an existing monument box.

N.22° E.	101.81'	Centerline top nut fire hydrant
N.67° W.	105.29'	P.K. nail and remon. tag S. face U-pole
S.25° W.	189.27'	S.E. corner building
S.37° E.	53.63'	P.K. nail and remon. tag N.E. face U-pole

STATE OF MICHIGAN
ROBERT D. KOHN
LAND SURVEYOR
NO.
26459
REGISTERED LAND SURVEYOR

The selected location is accepted by me and generally accepted by Professional Surveyors as the best available evidence of the position of the original corner.

Signed by Robert D. Kohn Date November 7, 1994

Surveyor's Michigan License No. 26459

FORM APPROVED BY MICHIGAN STATE BOARD OF LAND SURVEYORS, JAN. 28, 1971
REVISED MAY 14, 1975
REVISED JAN., 1983