

SURVEY & REMONUMENTATION

APR 28 1995

COMMISSION

LAND CORNER RECORDATION CERTIFICATE

Filing Requirement of Act 74, Mich. P.A. 1970

LIBER **6523** PAGE **945**

For corners in Macomb

Macomb Twp.

		Located In:		Corner Code #	
(County)					
		3N	13E	I-8	
1. Public Land Survey	T	_____	R	_____	_____
	T	_____	R	_____	_____
	T	_____	R	_____	_____
	T	_____	R	_____	_____
2. Property Controlling in Section	S	_____	T	_____	R
	S	_____	T	_____	R
3. Miscellaneous Property in Sec.	S	_____	T	_____	R
	S	_____	T	_____	R

C150798

94 DEC -9 PM 2: 50

CARMEL M. BAUGH
REGISTER OF DEEDS
MACOMB COUNTY, MI
Register of Deeds Stamp & File Number

4. Lot No. _____, Recorded Plat _____
5. Private Claims _____

Robert D. Kohn

July 26

94

I, _____, in a field survey on _____, 19 _____, do hereby certify that under requirements of P.A. 74, Michigan P.A. of 1970, the corner points mentioned in lines 1 and 2 above were in conformance with regulations and rules therefore as required in the current manual of survey instructions of the United States Department of the Interior, Bureau of Land Management or by a decree of a Court of Law and/or that the corner points mentioned in lines 3, 4 and 5 above were in conformance with the rules of the Michigan Board of Land Surveyors or by a Decree of a Court of Law; established, re-established, monumented, re-monumented, recovered, found as expressed below:

NOTE: Not more than 4 corners, all in the same town and range, may be recorded on this certificate.

	A	B	C	D	E	F	G	H	I	J	K	L	M
2	6	5	4	3	2	1							
3													
4	7	8	9	10	11	12							
5													
6	18	17	16	15	14	13							
7													
8	19	20	21	22	23	24							
9													
10	30	29	28	27	26	25							
11													
12	31	32	33	34	35	36							
13													

A. Description of original monument and accessories and/or subsequent restoration:

1817 Post	G.L.O.	W. Preston	N/A	Notes
1972 1/2" Bar	L.C.R.C.	H. Kobs	#14097	L2291 P652
1987 1/2" Rod	L.C.R.C.	J. Fenn	#23505	L4110 P522
1994 Rod in hand hole Survey		S. Young	#25885	L6415 P066

B. Description of corner evidence found and/or method applied in restoring or reestablishing corner:

A 1/2" iron rod in a gravel road still marks this corner. The following witness ties were used to recover and verify its position:

3 ties from L.C.R.C.	L2291 P652
2 ties from L.C.R.C.	L4110 P522

Field measurements were made between the following corners:

I-7 to I-8	2683.85	meas.			
	2640	G.L.O.	Notes		
	2683.83	rec.	L6415 P066	Survey	
	2683.73	rec.	A.E.W. Section breakdown		
I-8 to I-9	2693.03	meas.			
	2640	G.L.O.	Notes		
	2693.48	Real estate atlas			
	2693.02	rec.	L6415 P066	Survey	
	2692.83	rec.	A.E.W. Section breakdown		


ACCEPTED BY THE MACOMB COUNTY SURVEY PEER GROUP AS THE OFFICIAL CORNER UNDER MICHIGAN PUBLIC ACT 345 OF 1990 AT A MEETING HELD ON 9-27-94
William E. Soderberg
WILLIAM E. SODERBERG, P.S., CHAIRMAN

C. Description of monument for corner and accessories established to perpetuate locating the position of the corner:

I replaced the 1/2" iron with a 3/4" x 24" iron rod with 2" diameter aluminum cap stamped "Macomb County Monument MI Act 345 #26459" in a gravel road.

N.14° E.	81.18'	Set P.K. and remon. tag in W. face of a 30" tree
S.49° W.	88.90'	S.E. corner of house #49915
S.82° W.	130.28'	Nail & remon. tag in S. face U-pole
N.40° W.	110.39'	Set P.K. nail & remon. tag in E. face of an 18" tree

The selected location is accepted me and generally accepted by Professional Surveyors as the best available evidence of the position of the original corner.

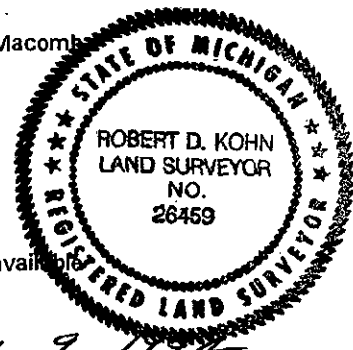

Signed by Robert D. Kohn Surveyor's Michigan License No. 26459

Date NOVEMBER 9, 1994