SURVEY &
REMONUMENTATION

APR 28 1995

COMMISSION

LAND CORNER RECORDATION CERTIFICATE

Filing Requirement of Act 74, Mich. P.A. 1970

LIBER 6523 PAGE 946

C150799

For corners in Macomb (County)

Macomb Twp.

	Located In:	Corner Code ##
	3N 13E	I-9
1. Public Land Survey	T ___ R ___	
	T ___ R ___	
	T ___ R ___	
	T ___ R ___	
2. Property Controlling	S ___ T ___ R ___	
in Section	S ___ T ___ R ___	
3. Miscellaneous	S ___ T ___ R ___	
Property in Sec.	S ___ T ___ R ___	

94 DEC -9 PM 2:50

CARMEN [illegible]AUGH
REGISTER OF DEEDS
MACOMB COUNTY, MI

Register of Deeds Stamp & File Number

4. Lot No. _____ , Recorded Plat _____
5. Private Claims _____

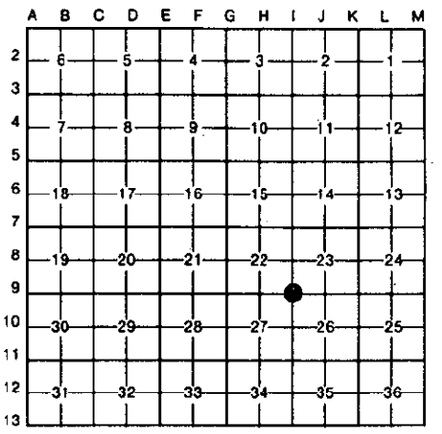

Robert D. Kohn July 26 94

I, _____ , in a field survey on _____ , 19 _____ , do hereby certify that under requirements of P.A. 74, Michigan P.A. of 1970, the corner points mentioned in lines 1 and 2 above were in conformance with regulations and rules therefore as required in the current manual of survey instructions of the United States Department of the Interior, Bureau of Land Management or by a decree of a Court of Law and/or that the corner points mentioned in lines 3, 4 and 5 above were in conformance with the rules of the Michigan Board of Land Surveyors or by a Decree of a Court of Law; established, re-established, monumented, re-monumented, recovered, found as expressed below:

NOTE: Not more than 4 corners, all in the same town and range, may be recorded on this certificate.

A. Description of original monument and accessories and/or subsequent restoration:

1817	N/A	N/A	W. Preston	N/A	N/A
1972	1/2" Bar	L.C.R.C.	H. Kobs	#14097	L2291 P650
1981	1/2" Bar	L.C.R.C.	H. Kobs	#14097	L3385 P264
1987	1/2" Iron rod	L.C.R.C.	J. Fenn	#23505	L4110 P522
1988	1/2" Iron re-rod	L.C.R.C.	M. Dunn	#30081	L4484 P575
1989	1/2" Rod	L.C.R.C.	W. Coulter	#14760	L4765 P541
1992	1/2" Iron bar	Survey	D. King	#30085	L5618 P72
1994	Re-rod	Survey	S. Young	#25885	L6415 P66

B. Description of corner evidence found and/or method applied in restoring or reestablishing corner:

A 1/2 " iron rod in a gravel road currently marks the location of this corner. The following witness ties were used to recover and verify its position:

1 tie from L.C.R.C. L2291 P650 & L3385 P264
3 ties from L.C.R.C. L4110 P522 & L4484 P575
2 ties from L.C.R.C. L4765 P541

Field measurements were made between the following corners:

I-9 to I-8	2693.03	meas.		
	2692.83	rec.	A.E.W. Section breakdown	
	2640.00	G.L.O.		
	2693.02	rec.	L6415 P66	Survey
I-9 to H-9	2684.50	meas.		
	2640.00	G.L.O.		
	2684.40	rec.	L5618 P72	Survey
	2704.42	rec.	A.E.W. Section breakdown	
I-9 to I-10	2668.74	meas.		
	2640.00	G.L.O.		
	2668.80	rec.	L5618 P72	Survey

ACCEPTED BY THE MACOMB COUNTY SURVEY PEER GROUP AS THE OFFICIAL CORNER UNDER MICHIGAN PUBLIC ACT 345 OF 1990 AT A MEETING HELD ON 9-27-94.

William E. Soderberg

WILLIAM E. SODERBERG, P.S., CHAIRMAN

C. Description of monument for corner and accessories established to perpetuate locating the position of the corner:

I replaced the 3/8" iron rod with a 3/4" x 24" iron rod with 2" diameter aluminum cap stamped "Macomb County Monument MI Act 345 #26459" in a gravel road.

S.72° W.	61.73'	P.K. nail & remon. tag S. face U-pole
N.38° W.	60.64'	Center bolt water valve box
N.22° E.	88.56'	Centerline top nut fire hydrant
S.80° E.	28.33'	P.K. nail and remon. tag N. face U-Pole

STATE OF MICHIGAN
ROBERT D. KOHN
LAND SURVEYOR
NO.
26459
REGISTERED LAND SURVEYOR

The selected location is accepted by me and generally accepted by Professional Surveyors as the best available evidence of the position of the original corner.

Signed by Robert D. Kohn Date November 9, 1994

Surveyor's Michigan License No. 26459

FORM APPROVED BY MICHIGAN STATE BOARD OF LAND SURVEYORS, JAN. 28, 1971
REVISED MAY 14, 1975
REVISED JAN., 1983