

SURVEY & REMONUMENTATION

APR 28 1995

COMMISSION

LAND CORNER RECORDATION CERTIFICATE

Filing Requirement of Act 74, Mich. P.A. 1970

LIBER **6523** PAGE **947**

C150800

For corners in Macomb

Macomb Twp.

	Located In:	Corner Code #	
	3N 13E	I-10	
1. Public Land Survey	T _____ R _____		_____
	T _____ R _____		_____
	T _____ R _____		_____
	T _____ R _____		_____
2. Property Controlling in Section	S _____ T _____ R _____		_____
	S _____ T _____ R _____		_____
3. Miscellaneous Property in Sec.	S _____ T _____ R _____		_____
	S _____ T _____ R _____		_____

94 DEC -9 PM 2: 50

CARYL L. SAGAUGH
REGISTER OF DEEDS
MACOMB COUNTY, MI

Register of Deeds Stamp & File Number

4. Lot No. _____, Recorded Plat _____
5. Private Claims _____

Robert D. Kohn

August 26

94

I, _____, in a field survey on _____, 19 _____, do hereby certify that under requirements of P.A. 74, Michigan P.A. of 1970, the corner points mentioned in lines 1 and 2 above were in conformance with regulations and rules therefore as required in the current manual of survey instructions of the United States Department of the Interior, Bureau of Land Management or by a decree of a Court of Law and/or that the corner points mentioned in lines 3, 4 and 5 above were in conformance with the rules of the Michigan Board of Land Surveyors or by a Decree of a Court of Law; established, re-established, monumented, re-monumented, recovered, found as expressed below:

NOTE: Not more than 4 corners, all in the same town and range, may be recorded on this certificate.

	A	B	C	D	E	F	G	H	I	J	K	L	M
2	6	5	4	3	2	1							
3													
4	7	8	9	10	11	12							
5													
6	18	17	16	15	14	13							
7													
8	19	20	21	22	23	24							
9													
10	30	29	28	27	26	25							
11													
12	31	32	33	34	35	36							
13													

A. Description of original monument and accessories and/or subsequent restoration:

1817	N/A	G.L.O.	W. Preston	N/A	Notes
1988	1/2" Iron rod	L.C.R.C.	M. Dunn	#30081	L4484 P577
1989	1/2" Iron rod	L.C.R.C.	M. Dunn	#30081	L4687 P328
1992	1/2" Iron bar	Survey	D. King	#30085	L5618 P72

B. Description of corner evidence found and/or method applied in restoring or reestablishing corner:

A 1/2" iron rod in a gravel road currently marks this corner. The following witness ties were used to recover and verify its position:

- 2 ties from L.C.R.C. L4484 P577
- 2 ties from L.C.R.C. L4687 P328

Field measurements were made between the following corners:


I-10 to I-9	2668.74	meas.	N/A	G.L.O.
	2668.80	rec.	L5618 P72	Survey
I-10 to I-11	2659.61	meas.	N/A	G.L.O.
	2659.75	rec.	Real estate atlas	
	2660.25	rec.	L38 P31	Plats

ACCEPTED BY THE MACOMB COUNTY SURVEY PEER
GROUP AS THE OFFICIAL CORNER UNDER MICHIGAN
PUBLIC ACT 345 OF 1990 AT A MEETING HELD
ON 9-27-94
William E. Soderberg
WILLIAM E. SODERBERG, P.S., CHAIRMAN

C. Description of monument for corner and accessories established to perpetuate locating the position of the corner:

I replaced the 1/2" iron rod with a 3/4" x 24" iron rod with 2" diameter aluminum cap stamped "Macomb County Monument MI Act 345 #26459" in a gravel road.

N.07° E.	255.21'	Centerline top nut fire hydrant
N.17° W.	183.89'	P.K. nail and remon. tag E. face U-pole
S.07° W.	211.32'	P.K. nail and remon. tag E. Face 36" tree
S.36° E.	43.29'	P.K. nail and remon. tag N.E. face U-pole

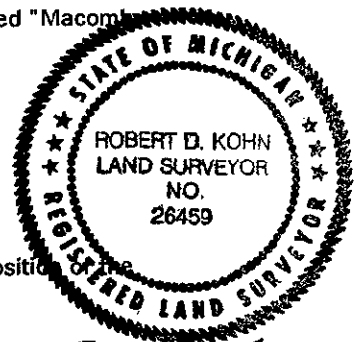

The selected location is accepted by Professional Surveyors as the best available evidence of the position of the original corner.

Signed by Robert D. Kohn
Surveyor's Michigan License No. 26459

Date November 9, 1994