SURVEY &
REMONUMENTATION

APR 28 1995

COMMISSION

LAND CORNER RECORDATION CERTIFICATE

Filing Requirement of Act 74, Mich. P.A. 1970

C150802

For corners in Macomb (County)

Macomb Twp.

	Located In:		Corner Code #
	3N	13E	I-12
1. Public Land Survey	T ____	R ____	_____
	T ____	R ____	_____
	T ____	R ____	_____
	T ____	R ____	_____
2. Property Controlling	S ____ T ____	R ____	_____
in Section	S ____ T ____	R ____	_____
3. Miscellaneous	S ____ T ____	R ____	_____
Property in Sec.	S ____ T ____	R ____	_____

LIBER 6523 PAGE 949
94 DEC -9 PM 2:50
CAROL A. SABAUGH
REGISTER OF DEEDS
MACOMB COUNTY, MI

Register of Deeds Stamp & File Number

4. Lot No. _____ , Recorded Plat _____
5. Private Claims _____

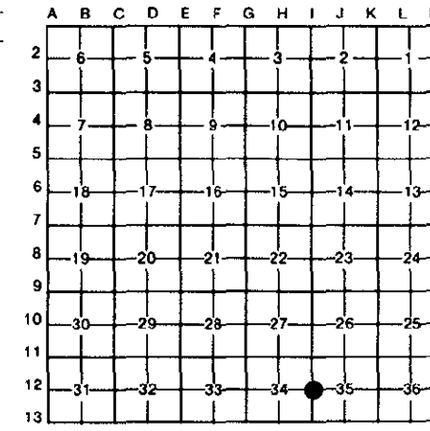

Robert D. Kohn July 27 94

I, _____ , in a field survey on _____ , 19 _____ , do hereby certify that under requirements of P.A. 74, Michigan P.A. of 1970, the corner points mentioned in lines 1 and 2 above were in conformance with regulations and rules therefore as required in the current manual of survey instructions of the United States Department of the Interior, Bureau of Land Management or by a decree of a Court of Law and/or that the corner points mentioned in lines 3, 4 and 5 above were in conformance with the rules of the Michigan Board of Land Surveyors or by a Decree of a Court of Law; established, re-established, monumented, re-monumented, recovered, found as expressed below:

NOTE: Not more than 4 corners, all in the same town and range, may be recorded on this certificate.

A. Description of original monument and accessories and/or subsequent restoration:

1817	Post	G.L.O.	W. Preston	N/A	Notes
1985	3/4" Pipe	L.C.R.C.	W. Avey	#30076	L3817 P910

B. Description of corner evidence found and/or method applied in restoring or reestablishing corner:

A 3/4" iron pipe in a monument box in asphalt pavement currently marks this corner. No witness points were recovered to verify its position.

ACCEPTED BY THE MACOMB COUNTY SURVEY PEER GROUP AS THE OFFICIAL CORNER UNDER MICHIGAN PUBLIC ACT 345 OF 1990 AT A MEETING HELD ON 9-27-94
William E. Soderberg
WILLIAM E. SODERBERG, P.S., CHAIRMAN

Field measurements were made between the following corners:

I-12 to I-13	2683.97	meas.		
	2640	G.L.O.		
	2683.90	rec.	L4421 P851	Survey
I-12 to I-11	2683.71	meas.		
	2640	G.L.O.		
	2683.62	rec.	L6372 P716-718	Condominium
	2683.62	rec.	L4421 P839	Survey

C. Description of monument for corner and accessories established to perpetuate locating the position of the corner:

I replaced the 3/4" iron pipe with a 3/4" x 24" iron rod with 2" diameter aluminum cap stamped "Macomb County Monument MI Act 345 #26459" in an existing monument box.

N.07° W.	245.16'	Centerline top nut fire hydrant
S.08° W.	257.93'	Centerline top nut fire hydrant
S.13° E.	154.15'	P.K. nail and remon tag. W. face 10" Pine
N.56° W.	56.82'	P.K. nail and remon. tag. S.W. face U-pole

STATE OF MICHIGAN
ROBERT D. KOHN
LAND SURVEYOR
NO.
26459
REGISTERED LAND SURVEYOR

The selected location is accepted by me and generally accepted by Professional Surveyors as the best available evidence of the position of the original corner.

Signed by Robert D. Kohn Date November 9, 1994

Surveyor's Michigan License No. 26459

FORM APPROVED BY MICHIGAN STATE BOARD OF LAND SURVEYORS, JAN. 28, 1971
REVISED MAY 14, 1975
REVISED JAN., 1983