

**SURVEY &
REMONUMENTATION**

**LAND CORNER RECORDATION CERTIFICATE
Filing Requirement of Act 74, Mich. P.A. 1970**

APR 07 1998

For corners in

Macomb
(County)

Located in: Macomb Twp. Corner Code # _____

SECTION _____

- | | | | |
|------------------------------------|--------|--------|--------|
| 1. Public Land Survey | T-3-N | R-13-E | J-1 |
| | T_____ | R_____ | _____ |
| | T_____ | R_____ | _____ |
| | T_____ | P_____ | _____ |
| 2. Property Controlling in Section | S_____ | T_____ | F_____ |
| | S_____ | T_____ | F_____ |
| 3. Miscellaneous Property in Sec. | S_____ | T_____ | R_____ |
| | S_____ | T_____ | R_____ |

C0623817 LIBER:07784 PAGE:394 08:57A 12/22/1997
CARMELLA SABAUGH-MACOMB COUNTY, MI REG/DEEDS

Register of Deeds Stamp & File Number _____

4. Lot No. _____, Recorded Plat _____

5. Private Claims _____

I, John N. Redash, in a field survey on October 16, 1997 do hereby state that under requirements of P.A. 74, Michigan P.A. of 1970, the corner points mentioned in lines 1 and 2 above were in conformance with regulations and rules therefore as required in the current manual of survey instructions of the United States Department of the Interior, Bureau of Land Management or by a decree of a Court of Law and /or that the corner points mentioned in lines 3, 4 and 5 above were in conformance with the rules of the Michigan Board of Land Surveyors or by a Decree of a Court of Law; established, re-established, monumented, recovered, found as expressed below:

NOTE: Not more than 2 corners, all in the same town and range, may be recorded on this certificate.

1	A	B	C	D	E	F	G	H	I	J	K	L	M
2		6		5		4		3		2		1	
3													
4		7		8		9		10		11		12	
5													
6		18		17		16		15		14		13	
7													
8		19		20		21		22		23		24	
9													
10		30		29		28		27		26		25	
11													
12		31		32		33		34		35		36	
13													


A. Description of original monument and accessories and/or subsequent restoration:

1817	No post set	G.L.O. Notes	W. Preston	N/A	N/A
1977	P.K. Nail and washer	Survey	G. James	#19835	L2811, P167
1991	1/2" iron bar	Survey	D. King	#30085	L5778, P394
1995	1/2" Iron	L.C.R.C.	D. King	#30085	L6586, P205

B. Description of corner evidence found and/or method applied in restoring or reestablishing corner:

A 1/2" Iron rod 0.1' below top of pavement and 1/2' north of centerline of asphalt pavement (26 Mile Road) currently occupies this corner. The following witness ties were used to recover and verify its position; 2 witness ties match current measurements from L.C.R.C. L6586, P205 and falls on line between corners I-13 and J-13.

I-1 to J-1	J-1 to K-1	J-1 to J-13
2720.77 meas.	2719.38 meas.	58.71 meas.
No. G.L.O.	No G.L.O.	No. G.L.O.
2720.60 Rec. Survey L2811, P167		
2721.01 Rec. Survey L5778, P394		

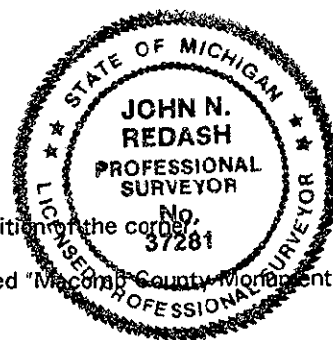

C. Description of monument for corner and accessories established to perpetuate locating the position of the corner:

I replaced the 1/2" iron rod in asphalt pavement with a 3/4" X 24" iron rod with a 2" aluminum cap stamped "Macomb County Monument MI Act 345 #37281" with a new monument box. Witness ties are as follows:

- N. 16° W. 195.32' S.W. corner house #22435
- N. 09° E. 175.03' S.E. corner house #22435
- N. 49° E. 88.63' Set P.K. nail and Macomb County Remon. tag N.W. face U-pole
- S. 48° W., 38.78' Set P.K. nail and Macomb County Remon. tag N.W. face 10" Elm
- Due East 58.71' Macomb County Remon. Cap and iron #37281 in monument box (J-13, T-4-N., R-13-E.)

The selected location is accepted by me and generally accepted by Professional Surveyors as the best available evidence of the position of the original corner.

Signed by John N. Redash
Surveyor's Michigan License No. 37281

Date December 16, 1997

FORM APPROVED BY MICHIGAN STATE BOARD OF PROFESSIONAL SURVEYORS, JAN. 28, 1971
REVISED MAY 14, 1978
REVISED JAN., 1983
REVISED OCT., 1986

ACCEPTED BY THE MACOMB COUNTY SURVEY PEER GROUP AS THE OFFICIAL CORNER UNDER MICHIGAN PUBLIC ACT 345 OF 1990 AT A MEETING HELD ON 12-18-97
William E. Soderberg
WILLIAM E. SODERBERG, P.S., CHAIRMAN

697