

LAND CORNER RECORDATION CERTIFICATE
Filing Requirement of Act 74, Mich. P.A. 1970

For corners in

Macomb Located In: Macomb Twp. Corner Code #
 (County)

1. Public Land Survey T-3-N R-13-E J-3
 T R
 T R
 T R

2. Property Controlling in Section S T R
 S T R


3. Miscellaneous Property in Sec. S T R
 S T R

SURVEY &
 REMONUMENTATION

MAR 15 1999

SECTION

Register of Deeds Stamp & File Number

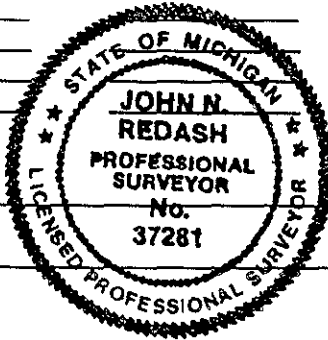

4. Lot No. , Recorded Plat

5. Private Claims

A	B	C	D	E	F	G	H	I	J	K	L	M
1												
2	6		5		4		3		2		1	
3												
4	7		8		9		10		11		12	
5												
6	18		17		16		15		14		13	
7												
8	19		20		21		22		23		24	
9												
10	30		29		28		27		26		25	
11												
12	31		32		33		34		35		36	
13												

I, John N. Redash, in a field survey on Jan. 6, 1998 do hereby state that under requirements of P.A. 74, Michigan P.A. of 1970, the corner points mentioned in lines 1 and 2 above were in conformance with regulations and rules therefore as required in the current manual of survey instructions of the United States Department of the Interior, Bureau of Land Management or by a decree of a Court of Law and/or that the corner points mentioned in lines 3, 4 and 5 above were in conformance with the rules of the Michigan Board of Land Surveyors or by a Decree of a Court of Law; established, re-established, monumented, recovered, found as expressed below:

NOTE: Not more than 2 corners, all in the same town and range, may be recorded on this certificate.

A. Description of original monument and accessories and/or subsequent restoration:

1817	4" dia. iron wood	G.L.O. Notes	W. Preston	N/A	N/A
1975	Found 1/2" pipe - Set iron	L.C.R.C.	G. Avendt	#16034	L2605, P594

B. Description of corner evidence found and/or method applied in restoring or reestablishing corner:

I found a 1/2" iron w/cap (not legible) set inside 1/2" pipe located at the intersection of a North/South and East/West fence line (both being 4' woven wire fences with barbed wire). The following witness ties were used to recover and verify its position: One tie matches current measurements from L.C.R.C. L2605, P594. Field measurements were observed between the following corners:

I-3 to J-3		J-3 to K-3	
2728.40	Meas.	2727.93	Meas.
2689.50	G.L.O.	2689.50	G.L.O.
2728.69	Rec. Tax Desc.	2728.20	Rec. Tax Desc.

ACCEPTED BY THE MACOMB COUNTY SURVEY PEER GROUP AS THE OFFICIAL CORNER UNDER MICHIGAN PUBLIC ACT 345 OF 1990 AT A MEETING HELD ON 10/13/98

 WILLIAM E. SODERBERG, P.S., CHAIRMAN

C. Description of monument for corner and accessories established to perpetuate locating the position of the corner:

I replaced the 1/2" iron rod with a 4" X 36" concrete monument with a 2" dia. aluminum cap stamped "Macomb County Monument MI Act 345 #37281". An old cedar fence post was found below the 1/2" iron rod while setting the concrete monument. Witnesses are as follows:

AZ. 13°	8.83'	Centerline steel pipe line marker
AZ. 70°	1.98'	P.K. nail and Macomb County Remon. tag S.E. face 8" Maple
AZ. 105°	15.68'	Found P.K. nail S.W. face Twin 8" Hawthorne
AZ. 255°	26.30'	P.K. nail and Macomb County Remon. tag S.E. face Triple 20" Maple

The selected location is accepted by me and generally accepted by Professional Surveyors as the best available evidence of the position of the original corner.

Signed by Date 12-23-98

Surveyor's Michigan License No. 37281

FORM APPROVED BY MICHIGAN STATE BOARD OF PROFESSIONAL SURVEYORS, JAN. 28, 1971
 REVISED MAY 14, 1975
 REVISED JAN., 1983
 REVISED OCT., 1995

Redash