

**SURVEY & REMONUMENTATION**

APR 29 1996

**LAND CORNER RECORDATION CERTIFICATE**

Filing Requirement of Act 74, Mich. P.A. 1970

For corners in **COMMISSION**  
Macomb  
(County)

Located In: Macomb Twp. Corner Code #

- |                                      |             |             |            |
|--------------------------------------|-------------|-------------|------------|
| 1. Public Land Survey                | T <u>3N</u> | R <u>3E</u> | <u>J-9</u> |
|                                      | T _____     | R _____     | _____      |
|                                      | T _____     | R _____     | _____      |
|                                      | T _____     | R _____     | _____      |
| 2. Property Controlling in Section   | S _____     | T _____     | R _____    |
|                                      | S _____     | T _____     | R _____    |
| 3. Miscellaneous Property in Section | S _____     | T _____     | R _____    |
|                                      | S _____     | T _____     | R _____    |

Register of Deeds Stamp & File Number

4. Lot No. \_\_\_\_\_, Recorded Plat \_\_\_\_\_  
5. Private Claims \_\_\_\_\_

A	B	C	D	E	F	G	H	I	J	K	L	M
2	6	6	4	3	2	1						
3												
4	7	8	9	10	11	12						
5												
6	13	17	16	15	14	13						
7												
8	19	20	21	22	23	24						
9												
10	30	29	28	27	26	25						
11												
12	31	32	33	34	35	36						
13												

I, Robert D. Kohn, in a field survey on July 6, 1995, do hereby certify that under requirements of P.A. 74, Michigan P.A. of 1970, the corner points mentioned in lines 1 and 2 above were in conformance with regulations and rules therefore as required in the current manual of survey instructions of the United States Department of the Interior, Bureau of Land Management or by a decree of a Court of Law and/or that the corner points mentioned in lines 3, 4 and 5 above were in conformance with the rules of the Michigan Board of Professional Surveyors or by a Decree of a Court of Law; established, re-established, monumented, re-monumented, recovered, found as expressed below:

**NOTE: Not more than 4 corners, all in the same town and range, may be recorded on this certificate.**

**A. Description of original monument and accessories and/or subsequent restoration:**

1817 G.L.O. Notes incomplete	W. Preston	n/a	n/a
1988 Found 1/2" Iron re-rod	L.C.R.C.	M. Dunn	#30081 L4484 P575
1988 1/2" Iron rod	Survey	S. Dunn	#28408 L4484 P579

**C0292255 LIBER:06862 PAGE:814 11:11A 12/21/1995  
CARMELLA SABAUGH-MACOMB COUNTY, MI REG/DEEDS**

**B. Description of corner evidence found and/or method applied in restoring or reestablishing corner:**

A 1/2" iron rod in a golf course fairway currently occupies this corner. The following witness ties were used to verify and recover its position:  
3 ties match L.C.R.C. L4484 P575  
3 ties match Survey L4484 P579

ACCEPTED BY THE MACOMB COUNTY SURVEY PEER GROUP AS THE OFFICIAL CORNER UNDER MICHIGAN PUBLIC ACT 345 OF 1990 AT A MEETING HELD ON 8-19-95  
William E. Soderberg  
WILLIAM E. SODERBERG, P.S., CHAIRMAN


Field measurements were made between the following corners:

I-9 to J-9	2656.72	meas.		
	G.L.O. notes incomplete			
J-9 to K-9	2751.90	meas.		
	G.L.O. notes incomplete			
	2752.09	rec.	Survey	L4484 P579

**C. Description of monument for corner and accessories established to perpetuate locating the position of the corner:**

I replaced the 1/2" iron rod in a golf course fairway with a 3/4" x 24" iron rod with a 2" diameter aluminum cap stamped "Macomb County Monument MI Act 345 #26459".

N.70° W.	122.72'	Nail and M.C.R. tag in N.E. face 32" Walnut
N.38° W.	44.33'	P.K. nail and tag #30092 E. face 20" Ash
N.42° E.	75.83'	P.K. nail and tag #30092 S.E. face 36" Hickory
S.30° W.	104.75'	P.K. nail and tag #30092 N.W. face 30" Walnut

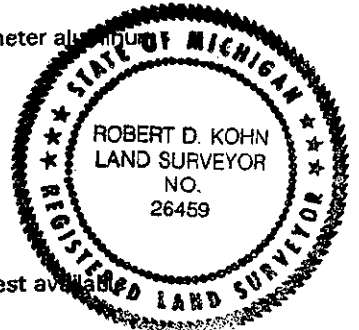

The selected location is accepted by me and generally accepted by Professional Surveyors as the best available evidence of the position of the original corner.

Signed by Robert D. Kohn  
Surveyor's Michigan License No. 26459

Date Dec. 11, 1995