

LAND CORNER RECORDATION CERTIFICATE
Filing Requirement of Act 74, Mich. P.A. 1970

**SURVEY &
REMONUMENTATION**

For corners in

Macomb
(County)

Located In: Macomb Twp. Corner Code #

APR 07 1998

SECTION

- | | | |
|------------------------------------|------------------------------|------------|
| 1. Public Land Survey | T- <u>3-N</u> R- <u>13-E</u> | <u>K-1</u> |
| | T _____ R _____ | _____ |
| | T _____ R _____ | _____ |
| | T _____ R _____ | _____ |
| 2. Property Controlling in Section | S _____ T _____ R _____ | _____ |
| | S _____ T _____ R _____ | _____ |
| 3. Miscellaneous Property in Sec. | S _____ T _____ R _____ | _____ |
| | S _____ T _____ R _____ | _____ |

ACCEPTED BY THE MACOMB COUNTY SURVEY PEER GROUP AS THE OFFICIAL CORNER UNDER MICHIGAN PUBLIC ACT 345 OF 1990 AT A MEETING HELD ON 11-19-97
William E. Soderberg
WILLIAM E. SODERBERG, P.S., CHAIRMAN

Register of Deeds Stamp & File Number

4. Lot No. _____, Recorded Plat _____

5. Private Claims _____

I, John N. Redash, in a field survey on October 17, 1997 do hereby state that under requirements of P.A. 74, Michigan P.A. of 1970, the corner points mentioned in lines 1 and 2 above were in conformance with regulations and rules therefore as required in the current manual of survey instructions of the United States Department of the Interior, Bureau of Land Management or by a decree of a Court of Law and/or that the corner points mentioned in lines 3, 4 and 5 above were in conformance with the rules of the Michigan Board of Land Surveyors or by a Decree of a Court of Law; established, re-established, monumented, recovered, found as expressed below:

NOTE: Not more than 2 corners, all in the same town and range, may be recorded on this certificate.

1	A	B	C	D	E	F	G	H	I	J	K	L	M
2		6		5		4		3		2		1	
3													
4		7		8		9		10		11		12	
5													
6		16		17		16		15		14		13	
7													
8		19		20		21		22		23		24	
9													
10		30		29		28		27		26		25	
11													
12		31		32		33		34		35		36	
13													

A. Description of original monument and accessories and/or subsequent restoration:

1817	Set post	G.L.O. Notes	W. Preston	N/A	N/A
1975	Found 1/2" iron	Survey	G. Avendt	#16034	L2282, P393
1975	Found 1/2" iron	Survey	G. Avendt	#16034	L2596, P125
1975	Found 1/2" iron	Survey	G. Avendt	#16034	L2585, P701
1978	Found 1/2" Re-rod	Survey	G. James	#19835	L3010, P270
1979	Found 1/2" iron	Survey	G. James	#19835	L3169, P19
1997	1/2" pipe	Survey	D. King	#30085	Unrecorded

B. Description of corner evidence found and/or method applied in restoring or reestablishing corner:


A 1/2" iron pipe in asphalt pavement at the intersection of Indian Trail and 26 Mile Road currently occupies this corner. The following witness ties were used to recover and verify its position; current measurements match 1 tie to survey. Witnesses listed on L2585, P701, L3010, P270 and 3 ties from unrecorded survey (D. King #30085). Field observations were obtained between the following corners indicating that K-1 falls on line between J-13 and K-13.

J-1 to K-1	K-1 to K-13	K-1 to L-1
2719.38 meas.	16.00 meas.	2708.88 meas.
No. G.L.O.	18.48 Rec. G.L.O.	No. G.L.O.
	15.85 Rec. Survey L2585, P701	2709.01 Rec. Survey Unrecorded D. King #30085
	15.48 Rec. Survey L3010, P270	

C. Description of monument for corner and accessories established to perpetuate locating the position of the corner:

I replaced the found 1/2" pipe in asphalt pavement with a 3/4" X 24" iron rod with a 2" aluminum cap stamped "Macomb County Monument MI Act 345 #37281" in a new monument box. Witness ties are as follows:

Due East	16.01'	Macomb County Remon. cap in monument box (K-13, T-4-N., R-13-E.)
N. 19° E.	35.59'	P.K. Nail and Macomb County Remon. washer W. face U-pole
S. 25° E.	35.81'	Cross in north rim storm manhole
S. 62° W.	65.93'	Cross at end concrete end section

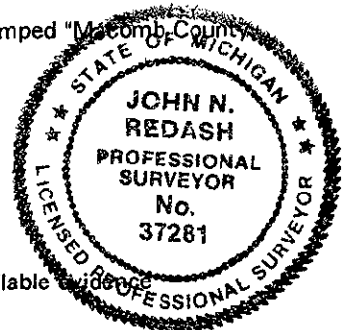

The selected location is accepted by me and generally accepted by Professional Surveyors as the best available evidence of the position of the original corner.

Signed by *John N. Redash*
Surveyor's Michigan License No. 37281

Date December 17, 1997