


**LAND CORNER RECORDATION CERTIFICATE**  
**Filing Requirement of Act 74, Mich. P.A. 1970**

For corners in

Macomb Located In: Macomb Twp. Corner Code #  
 (County)

1. Public Land Survey T-3-N R-13-E K-2  
 T R  
 T R  
 T R  
 2. Property Controlling in Section S T R  
 S T R  
 3. Miscellaneous Property in Sec. S T R  
 S T R

4. Lot No. \_\_\_\_\_, Recorded Plat \_\_\_\_\_  
 5. Private Claims \_\_\_\_\_

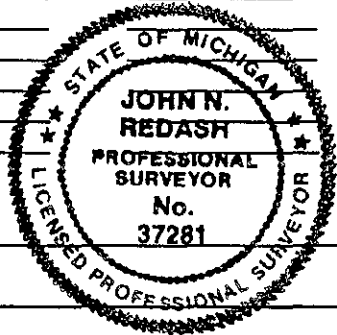

SURVEY &  
 REMONUMENTATION

MAR 15 1999

SECTION

Register of Deeds Stamp & File Number

I, John N. Redash, in a field survey on Jan. 6, 1998 do hereby state that under requirements of P.A. 74, Michigan P.A. of 1970, the corner points mentioned in lines 1 and 2 above were in conformance with regulations and rules therefore as required in the current manual of survey instructions of the United States Department of the Interior, Bureau of Land Management or by a decree of a Court of Law and for that the corner points mentioned in lines 3, 4 and 5 above were in conformance with the rules of the Michigan Board of Land Surveyors or by a Decree of a Court of Law; established, re-established, monumented, recovered, found as expressed below:

NOTE: Not more than 2 corners, all in the same town and range, may be recorded on this certificate.

A	B	C	D	E	F	G	H	I	J	K	L	M
1												
2	6	5	4	3	2	1						
3												
4	7	8	9	10	11	12						
5												
6	18	17	16	15	14	13						
7												
8	19	20	21	22	23	24						
9												
10	30	29	28	27	26	25						
11												
12	31	32	33	34	35	36						
13												

A. Description of original monument and accessories and/or subsequent restoration:

Date	Description	G.L.O. Notes	Surveyor	File #	File #
1817	4" dia. Hornbeam	G.L.O. Notes	W. Preston	N/A	N/A
1975	Found 1" square bar	Survey	R. Smith	#16052	L2574, P511
1975	Found 1" square bar	L.C.R.C.	R. Smith	#16052	L2574, P513
1975	Found 1" square bar	Survey	G. Avendt	#16034	L2596, P125
1977	Found 1" square bar	L.C.R.C.	W. Soderberg	#17635	L2882, P363
1978	Found 1" square bar	L.C.R.C.	W. Soderberg	#17635	L2900, P935
1979	Found 1" square bar	Survey	G. Avendt	#16034	L3169, P19
1980	Found 1" square bar	Survey	R. Smith	#16052	L3234, P850
1988	Found 1" square bar	L.C.R.C.	J. Fenn	#23505	L4475, P245

B. Description of corner evidence found and/or method applied in restoring or reestablishing corner:

A 1" square rod in an existing monument box in asphalt pavement at the intersection of North Avenue and Hagen Road currently occupies this corner. The following witness ties were used to recover and verify its position: Two ties match current measurements from L.C.R.C.s L2574, P513; L2882, P363; L2900, P935 and L4475, P245. Field measurements were observed between the following corners:

K-2 to K-1	2765.01 Meas.	K-2 to K-3	2694.52 Meas.	ACCEPTED BY THE MACOMB COUNTY SURVEY PEER GROUP AS THE OFFICIAL CORNER UNDER MICHIGAN PUBLIC ACT 345 OF 1990 AT A MEETING HELD ON <u>10/10/98</u>
2640.00 G.L.O.		2716.56 G.L.O.		
2764.46 Rec. Survey	L2596, P125			

*William E. Soderberg*  
 WILLIAM E. SODERBERG, P.S., CHAIRMAN

C. Description of monument for corner and accessories established to perpetuate locating the position of the corner:

I replaced the square 1" rod in an existing monument box with a 3/4" X 24" iron rod with a 2" dia. aluminum cap stamped "Macomb County Monument MI Act 345 #37281". Witnesses are as follows:

AZ.	78°	47.54'	Centerline stop sign
AZ.	135°	43.91'	Set mag nail and Macomb County Remon. tag in N. face utility pole
AZ.	238°	41.53'	Set mag nail and Macomb County Remon. tag in S.E. face utility pole
AZ.	306°	41.83'	Set P.K. nail and Macomb County Remon. tag N.E. face 6" Elm
AZ.	356°	167.28'	Set mag nail and Macomb County Remon. tag in East face utility pole

The selected location is accepted by me and generally accepted by Professional Surveyors as the best available evidence of the position of the original corner.

Signed by John N. Redash Date 12-23-98  
 Surveyor's Michigan License No. 37281