


LAND CORNER RECORDATION CERTIFICATE
Filing Requirement of Act 74, Mich. P.A. 1970

For corners in

Macomb
 (County)

Located in: Macomb Twp. Corner Code #

1. Public Land Survey T-3-N R-13-E K-3
 T R
 T R
 T R
 T R
2. Property Controlling in Section S T R
 S T R
3. Miscellaneous Property in Sec. S T R
 S T R

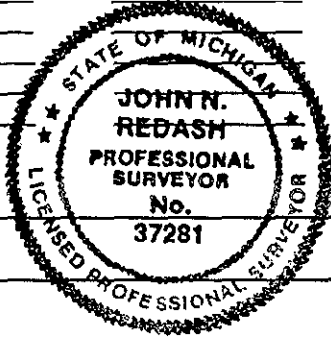

SURVEY &
 REMONUMENTATION

MAR 15 1999

SECTION

Register of Deeds Stamp & File Number

4. Lot No. , Recorded Plat
5. Private Claims

	A	B	C	D	E	F	G	H	I	J	K	L	M
1													
2	6		5		4		3		2		1		
3													
4	7		8		9		10		11		12		
5													
6	18		17		16		15		14		13		
7													
8	19		20		21		22		23		24		
9													
10	30		29		28		27		26		25		
11													
12	31		32		33		34		35		36		
13													

I, John N. Redash, in a field survey on Jan. 6, 1998 do hereby state that under requirements of P.A. 74, Michigan P.A. of 1970, the corner points mentioned in lines 1 and 2 above were in conformance with regulations and rules therefore as required in the current manual of survey instructions of the United States Department of the Interior, Bureau of Land Management or by a decree of a Court of Law and /or that the corner points mentioned in lines 3, 4 and 5 above were in conformance with the rules of the Michigan Board of Land Surveyors or by a Decree of a Court of Law; established, re-established, monumented, recovered, found as expressed below:

NOTE: Not more than 2 corners, all in the same town and range, may be recorded on this certificate.

A. Description of original monument and accessories and/or subsequent restoration:

1817	3" Dia. Black Ash	G.L.O. Notes	W. Preston	N/A	N/A
1988	Found P.K. nail in asphalt over 1" iron rod	L.C.R.C.	J. Fenn	#23505	L4475, P245

B. Description of corner evidence found and/or method applied in restoring or reestablishing corner:

A P.K. nail in asphalt pavement at centerline of North Avenue currently occupies this corner. There is fence line and tree line occupation to the East and West of this point. The following witness ties were used to recover and verify its position: One tie matches current measurements from L.C.R.C. L4475, P245. Field observations were obtained between the following corners:

J-3 to K-3		K-2 to K-3		K-3 to L-3		K-3 to K-4	
2727.93	Meas.	2694.52	Meas.	2681.72	Meas.	2655.50	Meas.
2689.50	G.L.O.	2640.00	G.L.O.	2656.50	G.L.O.	2640.00	G.L.O.
2728.20	Rec. Tax. Desc.					2655.93	Rec. Tax Desc.

C. Description of monument for corner and accessories established to perpetuate locating the position of the corner:

I replaced the found P.K. nail in asphalt pavement with a 3/4" X 24" iron rod with a 2" aluminum cap stamped "Macomb County Monument MI Act 345 #37281" in a new monument box. Witness ties are as follows:

AZ. 58°	42.54'	Chiseled "+" in top of steel "Petroleum pipeline marker"
AZ. 85°	32.84'	Found iron #19835
AZ. 147°	52.40'	Set mag. nail w/Remon. tag S.W. face 6" Oak tree
AZ. 210°	92.57'	Set P.K. nail and Macomb County Remon. tag in S.E. face of utility pole
AZ. 272°	34.51'	Set mag nail w/Remon. tag S. face R.R. tie fence post
AZ. 350°	90.44'	Set mag. nail w/Remon. tag E. face utility pole

The selected location is accepted by me and generally accepted by Professional Surveyors as the best available evidence of the position of the original corner.

Signed by *John N. Redash* Date 12-23-98
 Surveyor's Michigan License No. 37281

FORM APPROVED BY MICHIGAN STATE BOARD OF PROFESSIONAL SURVEYORS, JAN. 28, 1971
 REVISED MAY 14, 1975
 REVISED JAN., 1983
 REVISED OCT., 1995

ACCEPTED BY THE MACOMB COUNTY SURVEY PEER GROUP AS THE OFFICIAL CORNER UNDER MICHIGAN PUBLIC ACT 345 OF 1990 AT A MEETING HELD ON 10/13/98
William E. Soderberg
 WILLIAM E. SODERBERG, P.S., CHAIRMAN