

APR 29 1996

COMMISSION

LAND CORNER RECORDATION CERTIFICATE
Filing Requirement of Act 74, Mich. P.A. 1970

For corners in Macomb (County)

Located In: Macomb Twp. Corner Code #

- 1. Public Land Survey T3N R3E K-6
2. Property Controlling in Section S T R
3. Miscellaneous Property in Section S T R

Register of Deeds Stamp & File Number

- 4. Lot No. , Recorded Plat
5. Private Claims

I, Robert D. Kohn, in a field survey on July 1, 1995 do hereby certify that under requirements of P.A. 74, Michigan P.A. of 1970, the corner points mentioned in lines 1 and 2 above were in conformance with regulations and rules therefore as required in the current manual of survey instructions of the United States Department of the Interior, Bureau of Land Management or by a decree of a Court of Law and/or that the corner points mentioned in lines 3, 4 and 5 above were in conformance with the rules of the Michigan Board of Professional Surveyors or by a Decree of a Court of Law; established, re-established, monumented, re-monumented, recovered, found as expressed below:

Grid table with columns A-M and rows 1-13. A dot is marked at the intersection of column K and row 6.

NOTE: Not more than 4 corners, all in the same town and range, may be recorded on this certificate.

A. Description of original monument and accessories and/or subsequent restoration:

Table with columns: Date, Monument Type, Material, Surveyor, License #, Notes. Includes entries for 1817 Post, 1929 1" Solid iron, 1972 Hex. Head bolt, 1978 Hex. Head bolt, 1978 1" Solid bar, 1980 P.K. Nail.

B. Description of corner evidence found and/or method applied in restoring or reestablishing corner:


A 1/2" iron rod in an existing monument box in asphalt pavement currently occupies this corner. A tree line extends to the west of this corner. The following witness ties were used to recover and verify its position:
2 ties matches L3590 P347, 351 Survey
2 ties matches L3609 P521 Survey
2 ties matches L3795 P771-777 Survey
4 ties match L4151 P112, P110 Survey
4 ties match L4055, P674 L.C.R.C.
4 ties match L4543 P68, L4729 P144; L5969 P118; L5925 P74 Survey
SEE REVERSE SIDE OF THIS SHEET

ACCEPTED BY THE MACOMB COUNTY SURVEY PEER GROUP AS THE OFFICIAL CORNER UNDER MICHIGAN PUBLIC ACT 345 OF 1990 AT A MEETING HELD ON 8-15-95 WILLIAM E. SODERBERG, P.S., CHAIRMAN

C. Description of monument for corner and accessories established to perpetuate locating the position of the corner:

I replaced the existing 1/2" iron rod in an existing monument box in asphalt pavement with a 3/4" x 24" iron rod with a 2" diameter aluminum cap stamped "Macomb County Monument MI act 345 #26459."

- N.30° W. 96.96' P.K. nail and M.C.R. tag in N.E. face utility pole
N.35° E. 55.45' P.K. nail and M.C.R. tag in S.E. face triple 12" Poplar
S.85° E. 33.68' P.K. nail and M.C.R. tag in North face utility pole
S.30° W. 80.95' P.K. nail and M.C.R. tag in N.W. face utility pole
N.80° W. 68.40' Chain link fence post
N.40° W. 96.80' Chain link fence post

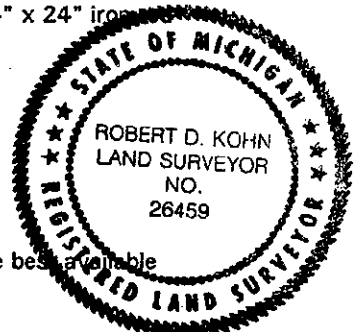

The selected location is accepted by me and generally accepted by Professional Surveyors as the best available evidence of the position of the original corner.

Signed by Robert D. Kohn
Surveyor's Michigan License No. 26459

Date DEC. 11, 1995

A. Description of original monument and accessories and/or subsequent restoration: (continued)

1986	1" iron bar in mon. box	Survey	H. Kobs	#14097	L4151 P110-111
1986	1" iron bar in mon. box	Survey	D. King	#30085	L4220 P449
1987	1" iron bar in mon. box	Survey	H. Kobs	#14097	L4306 P708; L4375 P862; L4543 P68
1992	1" bar in mn.box	L.C.R.C.	W. Avey	#30076	L5290 P293

*C0292288 LIBER:06862 PAGE:854 11:11A 12/21/1995
CARMELLA SABAUGH-MACOMB COUNTY, MI REG/DEEDS*