

APR 29 1996

COMMISSION

LAND CORNER RECORDATION CERTIFICATE
Filing Requirement of Act 74, Mich. P.A. 1970

For corners in Macomb Located In: Macomb Twp. Corner Code # _____
 (County)

- | | | | |
|--------------------------------------|-------------|---------------|------------|
| 1. Public Land Survey | T <u>3N</u> | R <u>R13E</u> | <u>L-5</u> |
| | T _____ | R _____ | _____ |
| | T _____ | R _____ | _____ |
| | T _____ | R _____ | _____ |
| 2. Property Controlling in Section | S _____ | T _____ | R _____ |
| | S _____ | T _____ | R _____ |
| 3. Miscellaneous Property in Section | S _____ | T _____ | R _____ |
| | S _____ | T _____ | R _____ |

Register of Deeds Stamp & File Number

4. Lot No. _____, Recorded Plat _____
 5. Private Claims _____

| | | | | | | | | | | | | |
|----|----|----|----|----|----|----|---|---|---|---|---|---|
| A | B | C | D | E | F | G | H | I | J | K | L | M |
| 2 | 6 | 5 | 4 | 3 | 2 | | | | | | | |
| 3 | | | | | | | | | | | | |
| 4 | 7 | 6 | 9 | 10 | 11 | 12 | | | | | | |
| 5 | | | | | | | | | | | | |
| 6 | 18 | 17 | 16 | 15 | 14 | 13 | | | | | | |
| 7 | | | | | | | | | | | | |
| 8 | 19 | 20 | 21 | 22 | 23 | 24 | | | | | | |
| 9 | | | | | | | | | | | | |
| 10 | 30 | 29 | 28 | 27 | 26 | 25 | | | | | | |
| 11 | | | | | | | | | | | | |
| 12 | 31 | 32 | 33 | 34 | 35 | 36 | | | | | | |
| 13 | | | | | | | | | | | | |

I, Robert D. Kohn, in a field survey on July 1, 1995, do hereby certify that under requirements of P.A. 74, Michigan P.A. of 1970, the corner points mentioned in lines 1 and 2 above were in conformance with regulations and rules therefore as required in the current manual of survey instructions of the United States Department of the Interior, Bureau of Land Management or by a decree of a Court of Law and/or that the corner points mentioned in lines 3, 4 and 5 above were in conformance with the rules of the Michigan Board of Professional Surveyors or by a Decree of a Court of Law; established, re-established, monumented, re-monumented, recovered, found as expressed below:

NOTE: Not more than 4 corners, all in the same town and range, may be recorded on this certificate.

A. Description of original monument and accessories and/or subsequent restoration:

| Year | Description | G.L.O. | Surveyor | Notes | Notes |
|------|---------------|-------------|----------|------------|-------|
| 1817 | Post | W. Preston | N/A | | |
| 1978 | 1/2" iron rod | W. Coulter | #14760 | L3027 P555 | |
| 1980 | Set iron | R. Kreger | #24601 | L3239 P345 | |
| 1983 | Iron rod | G. Kattouah | #14095 | L3590 P345 | |
| 1983 | Iron rod | G. Kattouah | #14095 | L3609 P521 | |
| 1992 | 1/2" iron | D. King | #30085 | L5969 P118 | |

B. Description of corner evidence found and/or method applied in restoring or reestablishing corner:

An existing 1/2" iron 0.40' below the surface of a gravel road currently occupies this corner. The following witness ties were used to recover and verify its position: (NOTE: evidence of a tree line to south.)
 3 ties match L.C.R.C. L3027 P555
 1 ties matches Survey L3590 P345; L3609 P521
 3 ties match Survey L5969 P118
 1 tie matches Survey L3239 P345


Field measurements were made between the following corners:

| | | | | |
|------------|---------|--------|--------|------------|
| K-5 to L-5 | 2681.05 | meas. | | |
| | 2658.40 | G.L.O. | | |
| | 2681.00 | rec. | survey | L3239 P345 |
| | 2681.11 | rec. | survey | L3609 P521 |
| L-5 to M-5 | 2683.71 | meas. | | |
| | 2658.40 | G.L.O. | | |

C. Description of monument for corner and accessories established to perpetuate locating the position of the corner:

I replaced the existing 1/2" iron rod in a gravel road with a 3/4" x 24" iron rod with a 2" diameter aluminum cap stamped "Macomb County Monument MI Act 345 #26459".

| | | |
|----------|--------|---|
| N.75° W. | 69.80' | P.K. nail and M.C.R. tag S. face 20" Oak |
| Due N. | 42.88' | P.K. nail and M.C.R. tag in E. face wood fence post |
| N.25° E. | 26.50' | P.K. nail and M.C.R. tag S.E. face 42" Oak |
| S.02° W. | 44.76' | P.K. nail and M.C.R. tag W. face 6" Elm |

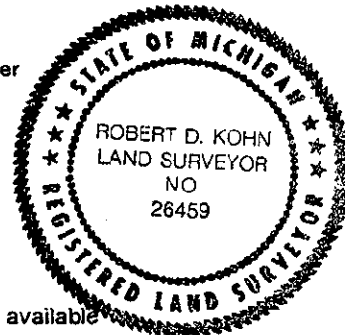

ACCEPTED BY THE MACOMB COUNTY SURVEY PEER GROUP AS THE OFFICIAL CORNER UNDER MICHIGAN PUBLIC ACT 345 OF 1980 AT A MEETING HELD ON 8-15-95
 WILLIAM E. SODERBERG, P.S., CHAIRMAN

The selected location is accepted by me and generally accepted by Professional Surveyors as the best available evidence of the position of the original corner.
 Signed by Robert D. Kohn Date Dec 11, 1995
 Surveyor's Michigan License No. 26459

FORM APPROVED BY MICHIGAN STATE BOARD OF PROFESSIONAL SURVEYORS, JAN. 28, 1971
 REVISED MAY 14, 1975
 REVISED JAN., 1993