

**SURVEY & REMONUMENTATION**

APR 29 1996

COMMISSION

**LAND CORNER RECORDATION CERTIFICATE**  
**Filing Requirement of Act 74, Mich. P.A. 1970**

For corners in Macomb Located In: Macomb Twp Corner Code # \_\_\_\_\_  
 (County)

		3N	13E	L-7
1. Public Land Survey	T	_____	R _____	_____
	T	_____	R _____	_____
	T	_____	R _____	_____
	T	_____	R _____	_____
2. Property Controlling in Section	S	_____	T _____	R _____
	S	_____	T _____	R _____
3. Miscellaneous Property in Section	S	_____	T _____	R _____
	S	_____	T _____	R _____

Register of Deeds Stamp & File Number

4. Lot No. \_\_\_\_\_, Recorded Plat \_\_\_\_\_  
 5. Private Claims \_\_\_\_\_

	A	B	C	D	E	F	G	H	I	J	K	L	M
2	6		5		4		3		2		1		
3													
4	7		8		9		10		11		12		
5													
6	18		17		16		15		14		13		
7													
8	19		20		21		22		23		24		
9													
10	30		29		28		27		26		25		
11													
12	31		32		33		34		35		36		
13													

I, Robert D. Kohn, in a field survey on July 1, 1995, do hereby certify that under requirements of P.A. 74, Michigan P.A. of 1970, the corner points mentioned in lines 1 and 2 above were in conformance with regulations and rules therefore as required in the current manual of survey instructions of the United States Department of the Interior, Bureau of Land Management or by a decree of a Court of Law and/or that the corner points mentioned in lines 3, 4 and 5 above were in conformance with the rules of the Michigan Board of Professional Surveyors or by a Decree of a Court of Law; established, re-established, monumented, re-monumented, recovered, found as expressed below:

NOTE: Not more than 4 corners, all in the same town and range, may be recorded on this certificate.

A. Description of original monument and accessories and/or subsequent restoration:

1817 Post	G.L.O.	W. Preston	N/A	Notes
1954 3/4" iron	M.C.R.C.	N/A	N/A	File No. 80
1975 3/4" iron bar	L.C.R.C.	H. Kobs	#14097	L2590 P348
1975 3/4" iron bar	Survey	H. Kobs	#14097	L2590 P338
1983 3/4" iron bar	Survey	H. Kobs	#14097	L3705 P61, 130
1986 3/4" iron bar	Survey	H. Kobs	#14097	L4151 P112
1986 3/4" iron bar	Survey	D. King	#30085	L4220 P449
1987 3/4" iron bar	Survey	H. Kobs	#14097	L4306 P704, L4375 P862

SEE REVERSE SIDE OF THIS SHEET

B. Description of corner evidence found and/or method applied in restoring or reestablishing corner:

A P.K. nail in the centerline of an asphalt road currently occupies this corner. A P.K. nail was also found 0.82' east of said nail. Wood and wire fence lines with brush, extend to the north and south of this corner. The following witness ties were used to recover and verify its position:

3 ties match L.C.R.C. L2590 P348  
 3 ties match Survey L2590 P338; L3705 P61; L3705 P130; L4151, P112; L4220 P449; L4306 P708, 704; L4375 P862; L4715 P220; L5290 P293;  
 4 ties match L.C.R.C. L5290 P293


SEE REVERSE SIDE OF THIS SHEET

ACCEPTED BY THE MACOMB COUNTY SURVEY PEER GROUP AS THE OFFICIAL CORNER UNDER MICHIGAN PUBLIC ACT 345 OF 1990 AT A MEETING HELD ON 8-15-95  
William E. Soderberg  
 WILLIAM E. SODERBERG, P.S., CHAIRMAN

C. Description of monument for corner and accessories established to perpetuate locating the position of the corner:

I replaced the found P.K. nail in asphalt pavement with a 3/4" x 24" iron rod with 2" diameter aluminum cap stamped "Macomb County Monument MI Act 345 #26459" with a new monument box.

Due N.	41.31'	P.K. nail and M.C.R. tag E. face utility pole
S.70° W.	51.92'	P.K. nail and M.C.R. tag in top guardrail post
Due S.	41.94'	Found concrete monument
S.60° E.	61.95'	P.K. nail and M.C.R. tag N.E. face utility pole

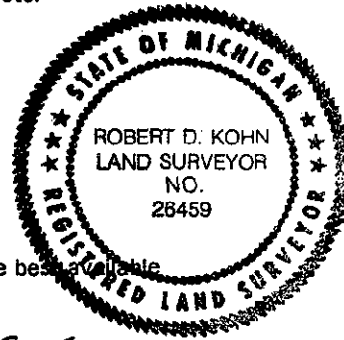

The selected location is accepted by me and generally accepted by Professional Surveyors as the best available evidence of the position of the original corner.

Signed by Robert D. Kohn Date Dec 11, 1995  
 Surveyor's Michigan License No. 26459

FORM APPROVED BY MICHIGAN STATE BOARD OF PROFESSIONAL SURVEYORS, JAN. 28, 1971  
 REVISED MAY 14, 1975  
 REVISED JAN., 1983

A. Description of original monument and accessories and/or subsequent restoration. (continued)

1989	3/4" iron bar	Survey	D. King	#30085	L4715 P220, L5290 P611
1992	3/4" iron bar	L.C.R.C.	W. Avey	#30076	L5290 P293
1993	3/4" iron bar	Survey	D. King	#30085	L6595 P678

B. Description of corner evidence found and/or method applied in restoring or reestablishing corner: (continued)

Field measurements were made between the following corners:

K-7 to L-7	2677.38	meas.			
	2649.90	rec.	G.L.O.		Notes
	2677.25	rec.	L2590 P380		Survey
L-7 to M-7	2677.25	rec.	L3705 P61, L4306 P708, L4375 P862		Survey
	2693.38	meas.			
	2649.90	rec.	G.L.O.		Notes
	2693.42	rec.	L4396 P293, L4715 P220, L5290, P611, L6595 P678		Survey

*C0292285 LIBER:06862 PAGE:848 11:11A 12/21/1995  
CARMELLA SABAUGH-MACOMB COUNTY, MI REG/DEEDS*