

**SURVEY &
REMONUMENTATION**

APR 28 1995 00158323 LIBER:06543 PAGE:345 08:35A 01/05/1995
CARMELLA SABAUGH-MACOMB COUNTY, MI REG/DEEDS

COMMISSION

**LAND CORNER RECORDATION CERTIFICATE
Filing Requirement of Act 74, Mich. P.A. 1970**

For corners in

<u>MACOMB</u> (County)	Located In:	Corner Code #
	<u>MACOMB TOWNSHIP</u>	
1. Public Land Survey	<u>T. 3N R. 13E</u>	<u>M-2</u>
	T _____ R _____	_____
	T _____ R _____	_____
	T _____ R _____	_____
2. Property Controlling in Section	S _____ T _____ R _____	_____
	S _____ T _____ R _____	_____
3. Miscellaneous Property in Sec.	S _____ T _____ R _____	_____
	S _____ T _____ R _____	_____

Register of Deeds Stamp & File Number

4. Lot No. _____, Recorded Plat _____
5. Private Claims _____

I, CRAIG P. AMEY, in a field survey on MAY 25, 19 94 do hereby certify that under requirements of P.A. 74, Michigan P.A. of 1970, the corner points mentioned in lines 1 and 2 above were in conformance with regulations and rules therefore as required in the current manual of survey instructions of the United States Department of the Interior, Bureau of Land Management or by a decree of a Court of Law and /or that the corner points mentioned in lines 3, 4 and 5 above were in conformance with the rules of the Michigan Board of Land Surveyors or by a Decree of a Court of Law; established, re-established, monumented, re-monumented, recovered, found as expressed below:

NOTE: Not more than 4 corners, all in the same town and range, may be recorded on this certificate.

A	B	C	D	E	F	G	H	I	J	K	L	M
2	6		5		4		3		2		1	
3												
4	7		8		9		10		11		12	
5												
6	18		17		16		15		14		13	
7												
8	19		20		21		22		23		24	
9												
10	30		29		28		27		26		25	
11												
12	31		32		33		34		35		36	
13												

A. Description of original monument and accessories and/or subsequent restoration:

G.L.O. (1817)	Page 055	William Preston	No witnesses remain
LCRC (1978)	Liber 2923 Page 875	Herbert J. Kobs, #14097	Found 1/2" iron
LCRC (1979)	Liber 3168 Page 266	John R. Fenn, #23505	Found 1/2" rerod
LCRC (1983)	Liber 3465 Page 178	Herbert J. Kobs, #14097	Found 1/2" iron bar
LCRC (1989)	Liber 4687 Page 333	Martin C. Dunn, #30081	Found 1/2" iron rod

Corner is common to A-2, T.3 N., R.14 E. Macomb County

B. Description of corner evidence found and/or method applied in restoring or reestablishing corner:


Found 1/2" rebar 0.3' below the surface of Hagen Road (gravel)
This corner verified by: Found and matched all existing recorded witnesses.
LCRC Liber 2923 Page 875
NNE 67.39' Nail and cap #123 in a power pole
ENE 62.40' The southwest corner of a concrete bridge abutment
SSW 25.35' Nail and cap #123 in a power pole
LCRC Liber 3168 Page 266
N 29.40' Nail and cap in the southwest root of a 40" ash
NE 63.46' Center of chiseled box on the west end of a headwall
SE 62.52' A pk nail in the top of a headwall
S 25.34' Nail and cap in a d.e. Pole
South 2664.68' Southwest corner of section 1
North 2669.89' Northwest corner of section 1

ACCEPTED BY THE MACOMB COUNTY SURVEY PEER GROUP AS THE OFFICIAL CORNER UNDER MICHIGAN PUBLIC ACT 345 OF 1990 AT A MEETING HELD ON 9-27-94
William E. Soderberg
WILLIAM E. SODERBERG, P.S., CHAIRMAN

C. Description of monument for corner and accessories established to perpetuate locating the position of the corner:

Replaced 1/2" pipe with a 3/4" x 24" iron and a Macomb County Remonumentation cap stamped:
"MACOMB COUNTY MONUMENT", "34970", "MI ACT 345"
80° 63.46' Found a chiseled square on the west end of a headwall
110° 62.52' Set a pk nail and MCR tag in the top of a headwall
180° 25.34' Found a nail and cap in a utility pole
300° 46.35' Set a pk nail and MCR tag in the south face of the western most guard rail

The selected location is accepted by me and is generally accepted by professional surveyors as the best available evidence of the position of the original corner.

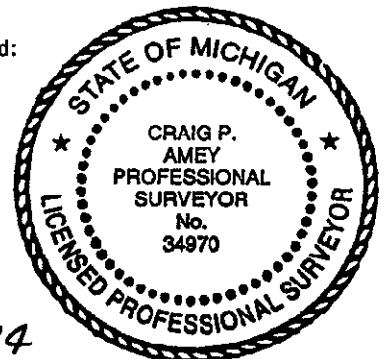

Signed by *Craig P. Amey* Date 12.15.94
Surveyor's Michigan License No. 34970