

SURVEY & REMONUMENTATION

APR 28 1995

C0158324 LIBER:06543 PAGE:346 08:35A 01/05/1995
 CARMELLA SABAUGH-MACOMB COUNTY, MI REG/DEEDS

COMMISSION

LAND CORNER RECORDATION CERTIFICATE
 Filing Requirement of Act 74, Mich. P.A. 1970

For corners in

<u>MACOMB</u> (County)	Located In:	Corner Code #
	<u>MACOMB TOWNSHIP</u>	
1. Public Land Survey	<u>T 3N R 13E</u>	<u>M-3</u>
	T <u> </u> R <u> </u>	<u> </u>
	T <u> </u> R <u> </u>	<u> </u>
	T <u> </u> R <u> </u>	<u> </u>
2. Property Controlling in Section	S <u> </u> T <u> </u> R <u> </u>	<u> </u>
	S <u> </u> T <u> </u> R <u> </u>	<u> </u>
3. Miscellaneous Property in Sec.	S <u> </u> T <u> </u> R <u> </u>	<u> </u>
	S <u> </u> T <u> </u> R <u> </u>	<u> </u>

Register of Deeds Stamp & File Number

4. Lot No. _____, Recorded Plat _____
 5. Private Claims _____

I, CRAIG P. AMEY, in a field survey on AUGUST 25, 19 94 do hereby certify that under requirements of P.A. 74, Michigan P.A. of 1970, the corner points mentioned in lines 1 and 2 above were in conformance with regulations and rules therefore as required in the current manual of survey instructions of the United States Department of the Interior, Bureau of Land Management or by a decree of a Court of Law and /or that the corner points mentioned in lines 3, 4 and 5 above were in conformance with the rules of the Michigan Board of Land Surveyors or by a Decree of a Court of Law; established, re-established, monumented, re-monumented, recovered, found as expressed below:

1	A	B	C	D	E	F	G	H	I	J	K	L	M
2		6		5		4		3		2		1	
3													
4		7		8		9		10		11		12	
5													
6		18		17		16		15		14		13	
7													
8		19		20		21		22		23		24	
9													
10		30		29		28		27		26		25	
11													
12		31		32		33		34		35		36	
13													

NOTE: Not more than 4 corners, all in the same town and range, may be recorded on this certificate.

A. Description of original monument and accessories and/or subsequent restoration:

1817 G.L.O. Pages 55-57	William Preston	No witnesses found
1979 LCRC Liber 3168 Page 267	John R Fenn, #23505	Found, 1/2" rerod
1979 LCRC Liber 3179 Page 738	William E Soderberg, #17635	Found, 1/2" rerod
1983 LCRC Liber 3465 Page 178	Herbert J. Kobs, #14097	Found, 1/2" iron bar w/cap #5557
1989 LCRC Liber 0487 Page 333	Martin C. Dunn, #30081	Found, 1/2" iron rod

Corner is common to A-3 T3N, R14E

B. Description of corner evidence found and/or method applied in restoring or reestablishing corner:

Found: 1/2" rebar with damaged cap, 0.3' below the surface of twenty five mile road (gravel)
 This corner verified by: found and matched existing witnesses

1979 LCRC Liber 3168 Page 267	Found, 1/2" Rerod
25.79' South	Found, Pk nail in fence post
65.25' Southwest	Found, Pk nail in d.e. Pole
41.73' W/southwest	Found, Pk nail in 6" ash
44.00' Northwest	Found, Pk nail in d.e. Pole
1979 LCRC Liber 3179 Page 738	Found, 1/2" rerod
43.99' Northwest	Found, Pk nail in southwest face of d.e. Pole
65.28' Southwest	Found, Pk nail in southeast face of d.e. Pole
25.80' South	Found, Pk nail in west face fence post
1989 LCRC Liber 4687 Page 333	Found, 1/2" rerod
43.99' Northwest	Found, Pk nail in southwest face of d.e. Pole
65.28' Southwest	Found, Pk nail in southeast face of d.e. Pole
25.80' South	Found, Pk nail in west face fence post

ACCEPTED BY THE MACOMB COUNTY SURVEY PEER GROUP AS THE OFFICIAL CORNER UNDER MICHIGAN PUBLIC ACT 345 OF 1990 AT A MEETING HELD ON 9-27-94
William E. Soderberg
 WILLIAM E. SODERBERG, P.S., CHAIRMAN


North 2664.68' To the west quarter post of section 1
 South 2665.21' To the west quarter post of section 12

C. Description of monument for corner and accessories established to perpetuate locating the position of the corner:

Replaced 1/2" rerod with a 3/4" x 24" iron and a Macomb County Remonumentation cap stamped:

"MACOMB COUNTY MONUMENT", "34970", "MI ACT 345"
 S 25.84' PK and MCR tag in the west side of a fence post
 SW 65.29' PK and MCR tag in the east face of a DE pole.
 WSW 41.64' PK and MCR tag in the southeast side of a triple 8" ash
 NW 44.00' PK and MCR tag in the southwest face of a DE pole

The selected location is accepted by me and is generally accepted by Professional Surveyors as the best available evidence of the position of the original corner

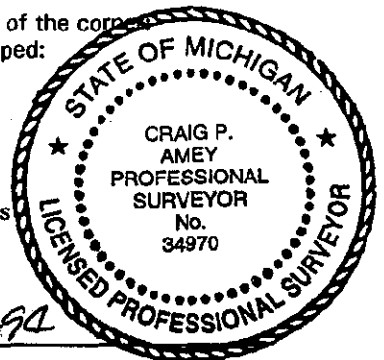

Signed by Craig P. Amey Date 12-15-94
 Surveyor's Michigan License No. 34970