

**SURVEY &
REMONUMENTATION**

C0158325 LIBER:06543 PAGE:347 08:35A 01/05/1995

APR 28 1995

CARMELLA SABAUGH-MACOMB COUNTY, MI REG/DEEDS

COMMISSION

**LAND CORNER RECORDATION CERTIFICATE
Filing Requirement of Act 74, Mich. P.A. 1970**

For corners in

<u>CHESTERFIELD</u> (County)	Located In:	Corner Code #
	MACOMB TOWNSHIP	
1. Public Land Survey	<u>T 3N R 13E</u>	<u>M-4</u>
	T _____ R _____	_____
	T _____ R _____	_____
	T _____ R _____	_____
2. Property Controlling in Section	S _____ T _____ R _____	_____
	S _____ T _____ R _____	_____
3. Miscellaneous Property in Sec.	S _____ T _____ R _____	_____
	S _____ T _____ R _____	_____

Register of Deeds Stamp & File Number

4. Lot No. _____, Recorded Plat _____
5. Private Claims _____

I, CRAIG P. AMEY, in a field survey on AUGUST 25, 19 94 do hereby certify that under requirements of P.A. 74, Michigan P.A. of 1970, the corner points mentioned in lines 1 and 2 above were in conformance with regulations and rules therefore as required in the current manual of survey instructions of the United States Department of the Interior, Bureau of Land Management or by a decree of a Court of Law and for that the corner points mentioned in lines 3, 4 and 5 above were in conformance with the rules of the Michigan Board of Land Surveyors or by a Decree of a Court of Law; established, re-established, monumented, re-monumented, recovered, found as expressed below:

NOTE: Not more than 4 corners, all in the same town and range, may be recorded on this certificate.

	A	B	C	D	E	F	G	H	I	J	K	L	M
1													
2	6		5		4		3		2		1		
3													
4	7		8		9		10		11		12		
5													
6	18		17		16		15		14		13		
7													
8	19		20		21		22		23		24		
9													
10	30		29		28		27		26		25		
11													
12	31		32		33		34		35		36		
13													

A. Description of original monument and accessories and/or subsequent restoration:

GLO 1817	Pages 55-57	William Preston	No witnesses found
LCRC 1976	L 2687 P 612	Robert L. Smith, #16052	Found 1" iron
LCRC 1987	L 4306 P 691	Herbert J. Kobs, #14097	Found 1" iron bar

Corner is common to A-4 T3N, R14E

B. Description of corner evidence found and/or method applied in restoring or reestablishing corner:

Found, 1" iron at intersection of north, south and west fence lines in a field approximately 1320' east of fairchild rd.
This corner verified by: Found and matched existing witnesses

LCRC	L 4306 P 691	
N	23.65'	Found form nail in 10" oak
ENE	2.35'	Found form nail in a 6" oak
E	28.43'	Found form nail in a 12" oak
S	16.07'	Found form nail in a 42" oak

ACCEPTED BY THE MACOMB COUNTY SURVEY PEER GROUP AS THE OFFICIAL CORNER UNDER MICHIGAN PUBLIC ACT 345 OF 1990 AT A MEETING HELD ON 9-27-94

William E. Soderberg
WILLIAM E. SODERBERG, P.S., CHAIRMAN


S	2669.24'	To the southeast corner of section 12
N	2665.21'	To the northwest corner of section 12

C. Description of monument for corner and accessories established to perpetuate locating the position of the corner:

Replaced 1/2" pipe with a 3/4" x 24" iron and a macomb county remonumentation cap stamped:
"MACOMB COUNTY MONUMENT"
"34970"
"MI ACT 345"

73°	2.35'	Form nail in the south face of a 6" oak
97°	28.43'	Form nail in the south face of a 12" oak
178°	17.30'	Form nail in the west face of a 42" oak
330°	23.65'	Form nail in the east face of a 10" oak

The selected location is accepted by me and is generally accepted by professional surveyors as the best available evidence of the position of the original corner.

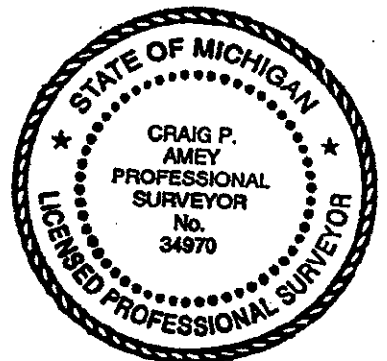

Signed by Craig P. Amey
Surveyor's Michigan License No. 34970

Date 12-15-94