

# SURVEY & REMONUMENTATION

APR 28 1995 C0158326 LIBER:06543 PAGE:348 08:35A 01/05/1995  
 CARMELLA SABAUGH-MACOMB COUNTY, MI REG/DEEDS

## COMMISSION

## LAND CORNER RECORDATION CERTIFICATE Filing Requirement of Act 74, Mich. P.A. 1970

For corners in

<u>MACOMB</u> (County)	Located In:	Corner Code #
	MACOMB TOWNSHIP	
1. Public Land Survey	T <u>3N</u> R <u>13E</u>	<u>M-5</u>
	T _____ R _____	_____
	T _____ R _____	_____
	T _____ R _____	_____
2. Property Controlling in Section	S _____ T _____ R _____	_____
	S _____ T _____ R _____	_____
3. Miscellaneous Property in Sec.	S _____ T _____ R _____	_____
	S _____ T _____ R _____	_____

Register of Deeds Stamp & File Number

4. Lot No. \_\_\_\_\_, Recorded Plat \_\_\_\_\_  
 5. Private Claims \_\_\_\_\_

I, CRAIG P. AMEY, in a field survey on AUGUST 25, 19 94 do hereby certify that under requirements of P.A. 74, Michigan P.A. of 1970, the corner points mentioned in lines 1 and 2 above were in conformance with regulations and rules therefore as required in the current manual of survey instructions of the United States Department of the Interior, Bureau of Land Management or by a decree of a Court of Law and /or that the corner points mentioned in lines 3, 4 and 5 above were in conformance with the rules of the Michigan Board of Land Surveyors or by a Decree of a Court of Law; established, re-established, monumented, re-monumented, recovered, found as expressed below:

NOTE: Not more than 4 corners, all in the same town and range, may be recorded on this certificate.

1	A	B	C	D	E	F	G	H	I	J	K	L	M
2		6		5		4		3		2		1	
3													
4		7		8		9		10		11		12	
5													
6		18		17		16		15		14		13	
7													
8		19		20		21		22		23		24	
9													
10		30		29		28		27		26		25	
11													
12		31		32		33		34		35		36	
13													

A. Description of original monument and accessories and/or subsequent restoration:

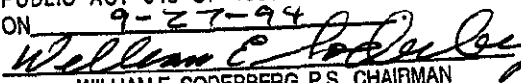
G.L.O.	Pages 55-57	William Preston	No witnesses found
LCRC 1976	L 2687 P 612	Robert L. Smith, #16052	Found 1" iron
LCRC 1978	L 3027 P 555	William J. Coulter, #14760	Found 1" iron rod in gravel road
LCRC 1979	L 3055 P 842	Robert L. Smith, #16052	Found 1/2" iron
LCRC 1980	L 3287 P 582	Herbert J. Kobs, #14097	Found 1/2" iron bar

Corner is common to A-5 T3N, R14E

B. Description of corner evidence found and/or method applied in restoring or reestablishing corner:

Found: bent 1/2" iron flush with surface of twenty four mile road (gravel)  
 This corner verified by: found and matched existing witnesses

- LCRC L 2687 P 612
  - S45E 65.83' Found top nut on hydrant
  - N 41.10' Found Chain link anchor post
- LCRC L 3027 P 555
  - SE 65.63' Found Top nut on hydrant
  - N 41.10' Found Corner fence post
- LCRC L 3055 P 842
  - N 20.61' Found Pk nail in power pole
- S45E 65.65' Found Top of fire hydrant
- LCRC L 3287 P 582
  - N 50.57' Found Pk nail in utility pole
  - SE 65.61' Found top of fire hydrant

ACCEPTED BY THE MACOMB COUNTY SURVEY PEER GROUP AS THE OFFICIAL CORNER UNDER MICHIGAN PUBLIC ACT 345 OF 1990 AT A MEETING HELD ON 9-27-94  
  
 WILLIAM E. SODERBERG, P.S., CHAIRMAN

- N 2669.24' To the West quarter post of section 12
- E 2702.22' To the South quarter post of section 13

C. Description of monument for corner and accessories established to perpetuate locating the position of the corner:

REPLACED 1/2" PIPE WITH A 3/4" x 24" IRON AND A MACOMB COUNTY REMONUMENTATION CAP STAMPED:  
 "MACOMB COUNTY MONUMENT"  
 "34970"  
 "MI ACT 345"

- 130° 65.75' Found the top of a fire hydrant
- 5° 20.57' Found a pk nail in a utility pole
- 180° 57.08' Set
- 290° 72.42' Found the top of a fire hydrant

The selected location is accepted by me and is generally accepted by professional surveyors as the best available evidence of the position of the original corner.

Signed by Craig P. Amey Date 12-15-94  
 Surveyor's Michigan license no. 34970

