

**SURVEY & REMONUMENTATION**

C0158328 LIBER:06543 PAGE:350 08:35A 01/05/1995  
 CARMELLA SABAUGH-MACOMB COUNTY, MI REG/DEEDS

APR 28 1995

**LAND CORNER RECORDATION CERTIFICATE**  
**Filing Requirement of Act 74, Mich. P.A. 1970**

For corners in **COMMISSION**

MACOMB Located In: MACOMB TOWNSHIP Corner Code #  
 (County)

1. Public Land Survey T 3N R 13E M-7  
 T     R      
 T     R      
 T     R    

2. Property Controlling S     T     R      
 in Section S     T     R    

3. Miscellaneous S     T     R      
 Property in Sec. S     T     R    

Register of Deeds Stamp & File Number

4. Lot No. \_\_\_\_\_, Recorded Plat \_\_\_\_\_  
 5. Private Claims \_\_\_\_\_

I, CRAIG P. AMEY, in a field survey on AUGUST 25, 19 94 do hereby certify that under requirements of P.A. 74, Michigan P.A. of 1970, the corner points mentioned in lines 1 and 2 above were in conformance with regulations and rules therefore as required in the current manual of survey instructions of the United States Department of the Interior, Bureau of Land Management or by a decree of a Court of Law and/or that the corner points mentioned in lines 3, 4 and 5 above were in conformance with the rules of the Michigan Board of Land Surveyors or by a Decree of a Court of Law; established, re-established, monumented, re-monumented, recovered, found as expressed below:

**NOTE: Not more than 4 corners, all in the same town and range, may be recorded on this certificate.**

|    | A | B  | C | D  | E | F  | G | H  | I | J  | K | L  | M |
|----|---|----|---|----|---|----|---|----|---|----|---|----|---|
| 1  |   |    |   |    |   |    |   |    |   |    |   |    |   |
| 2  |   | 6  |   | 5  |   | 4  |   | 3  |   | 2  |   | 1  |   |
| 3  |   |    |   |    |   |    |   |    |   |    |   |    |   |
| 4  |   | 7  |   | 8  |   | 9  |   | 10 |   | 11 |   | 12 |   |
| 5  |   |    |   |    |   |    |   |    |   |    |   |    |   |
| 6  |   | 16 |   | 17 |   | 16 |   | 15 |   | 14 |   | 13 |   |
| 7  |   |    |   |    |   |    |   |    |   |    |   |    |   |
| 8  |   | 19 |   | 20 |   | 21 |   | 22 |   | 23 |   | 24 |   |
| 9  |   |    |   |    |   |    |   |    |   |    |   |    |   |
| 10 |   | 30 |   | 29 |   | 28 |   | 27 |   | 26 |   | 25 |   |
| 11 |   |    |   |    |   |    |   |    |   |    |   |    |   |
| 12 |   | 31 |   | 32 |   | 33 |   | 34 |   | 35 |   | 36 |   |
| 13 |   |    |   |    |   |    |   |    |   |    |   |    |   |

A. Description of original monument and accessories and/or subsequent restoration:

|        |      |              |                         |                              |
|--------|------|--------------|-------------------------|------------------------------|
| GLO    | 1818 |              | William Preston         | No witnesses remain          |
| LCRC   | 1984 | L 3705 P 139 | Herbert J. Kobs, #14097 | Found, 5/8" iron bar         |
| LCRC   | 1987 | L 4306 P 693 | Donald M. King, #30085  | Found, 1/2" iron in pavement |
| Survey | 1990 | L 4942 P 368 | Martin C. Dunn, #30081  | Found 1/2" iron rod          |
| LCRC   | 1992 | L 5290 P 293 | Warren C. Avey, #30076  | Found 1/2" bar               |
| LCRC   | 1991 | L 5024 P 936 | Frank DeDecker, #8386   | Found 1/2" iron rod          |

Corner is common to A-7 T3N, R14E

B. Description of corner evidence found and/or method applied in restoring or reestablishing corner:

Found, 1/2" iron in the eastbound lane of 23 Mile road, 0.3' below the surface (asphalt).

This corner verified by: found and matched the following records:

|      |                     |   |
|------|---------------------|---|
| LCRC | L 3705 P 139        |   |
| SE   |                     | Chiseled cross on the northeast side of 2" diameter gate post |
| LCRC | L 4306 P 693        |   |
| SE   | 36.60'              | Chiseled cross on the east side of a gate post                |
| S    | 33.40'              | Chiseled cross on the west side of a steel anchor post        |
| S    | 62.85'              | Chiseled cross on the east side of a steel fence post         |
| LCRC | L 5024 P 936        |   |
| 74°  | 118.97'             | Pk nail in southeast face of a power pole                     |
| 109° | 113.90'             | Pk nail in northeast face of a power pole.                    |
| 260° | 125.33'             | Pk nail with sda tag in nw face of a guy pole                 |
| 211° | 112.75'             | Se corner of house #24980                                     |
| LCRC | L 5290 P 293        |   |
| SSE  | 36.60'              | Chiseled cross on the northeast side of a steel fence post    |
| SE   | 62.98'              | Chiseled cross on the west side of a steel Fence post         |
| N    | 42.60'              | Pk nail in top of wood fence post                             |
| S    | 33.42'              | Chiseled cross on the west side of a steel fence post         |
| S    | 2686.23' (40.70 ch) | East quarter post of section 24                               |
| N    | 2653.89' (40.21 ch) | East quarter post of section 13                               |


ACCEPTED BY THE MACOMB COUNTY SURVEY PEER GROUP AS THE OFFICIAL CORNER UNDER MICHIGAN PUBLIC ACT 345 OF 1990 AT A MEETING HELD ON 10-18-94  
William E. Soderberg  
 WILLIAM E. SODERBERG, P.S., CHAIRMAN

C. Description of monument for corner and accessories established to perpetuate locating the position of the corner:

Replaced 1/2" pipe with a 3/4" x 24" iron and a Macomb County Remonumentation cap stamped:

|      |         |   |
|------|---------|---|
|      |         | "MACOMB COUNTY MONUMENT", "34970", "MI ACT 345"             |
| 74°  | 118.97' | Found Pk nail in the southeast face of a utility pole       |
| 109° | 113.90' | Found Pk nail in the northeast face of a utility pole       |
| 260° | 125.33' | Found Pk nail w/SDA tag in the northwest face of a guy pole |
| 211° | 112.75' | Found the southeast corner of house #24980                  |

The selected location is accepted by me and is generally accepted by Professional Surveyors as the best available evidence of the position of the original corner.

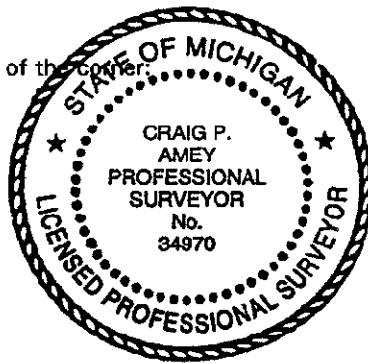

Signed by Craig P. Amey  
 Surveyor's Michigan License No. 34970

Date 12-15-94