

SURVEY & REMONUMENTATION

APR 28 1995 0158330 LIBER:06543 PAGE:352 08:35A 01/05/1995
 CARMELLA SABAUGH-MACOMB COUNTY, MI REG/DEEDS

COMMISSION

LAND CORNER RECORDATION CERTIFICATE Filing Requirement of Act 74, Mich. P.A. 1970

For corners in

<u>MACOMB</u> (County)	Located In:	Corner Code #
	<u>MACOMB TOWNSHIP</u>	
1. Public Land Survey	<u>T 3N R 13E</u>	<u>M-10</u>
	T <u> </u> R <u> </u>	<u> </u>
	T <u> </u> R <u> </u>	<u> </u>
	T <u> </u> R <u> </u>	<u> </u>
2. Property Controlling in Section	S <u> </u> T <u> </u> R <u> </u>	<u> </u>
	S <u> </u> T <u> </u> R <u> </u>	<u> </u>
3. Miscellaneous Property in Sec.	S <u> </u> T <u> </u> R <u> </u>	<u> </u>
	S <u> </u> T <u> </u> R <u> </u>	<u> </u>

Registrar of Deeds Stamp & File Number

4. Lot No. _____, Recorded Plat _____
 5. Private Claims _____

I, CRAIG P. AMEY, in a field survey on MAY 25, 19 94 do hereby certify that under requirements of P.A. 74, Michigan P.A. of 1970, the corner points mentioned in lines 1 and 2 above were in conformance with regulations and rules therefore as required in the current manual of survey instructions of the United States Department of the Interior, Bureau of Land Management or by a decree of a Court of Law and/or that the corner points mentioned in lines 3, 4 and 5 above were in conformance with the rules of the Michigan Board of Land Surveyors or by a Decree of a Court of Law; established, re-established, monumented, re-monumented, recovered, found as expressed below:

NOTE: Not more than 4 corners, all in the same town and range, may be recorded on this certificate.

A	B	C	D	E	F	G	H	I	J	K	L	M
6	5	4	3	2	1							
7	8	9	10	11	12							
18	17	16	15	14	13							
19	20	21	22	23	24							
30	29	28	27	26	25							
31	32	33	34	35	36							

A. Description of original monument and accessories and/or subsequent restoration:

G.L.O. (1817) WILLIAM PRESTON NO WITNESSES REMAIN
 SURVEY (1980) LIBER 3293 PAGE 828 WILLIAM E. SODERBERG #17635 FOUND 3/4" PIPE IN MONUMENT BOX
 CORNER IS COMMON TO A-10, T.3N., R.14E., MACOMB COUNTY

B. Description of corner evidence found and/or method applied in restoring or reestablishing corner:

FOUND 3/4" PIPE ADJACENT TO CONCRETE POST (MONUMENT BOX GONE)
 THIS CORNER VERIFIED BY: FOUND AND MATCHED ALL EXISTING RECORDED WITNESSES.


SURVEY LIBER 3293 PAGE 828
 S 41° W 10.93' FOUND 26" ELM (NOW A STUMP)
 S 76° W 20.97' FOUND 12" TWIN OAK
 WEST 00.20' FOUND CONCRETE POST
 NORTH 2668.47' NORTHWEST CORNER OF SECTION 25 (M-9)
 SOUTH 2684.51' SOUTHWEST CORNER OF SECTION 25 (M-11)

ACCEPTED BY THE MACOMB COUNTY SURVEY PEER GROUP AS THE OFFICIAL CORNER UNDER MICHIGAN PUBLIC ACT 345 OF 1990 AT A MEETING HELD ON 9-27-94
William E. Soderberg
 WILLIAM E. SODERBERG, P.S., CHAIRMAN

C. Description of monument for corner and accessories established to perpetuate locating the position of the corner:

REPLACED 3/4" PIPE WITH A 3/4" x 24" IRON AND A MACOMB COUNTY REMONUMENTATION CAP STAMPED:
 "MACOMB COUNTY MONUMENT"
 "34970"
 "MI ACT 345"

- 005° 2.75' SET A CHISELED "X" ON THE WEST FACE OF A FENCE POST
- 100° 83.85' SET A PK ON A CONCRETE JOINT IN UTICA STEEL PARKING LOT
- 175° 27.80' SET A PK AND MCR TAG IN THE WEST FACE OF A 13" ASH
- 248° 29.00' SET A PK AND MCR TAG IN THE WEST FACE OF A 15" OAK

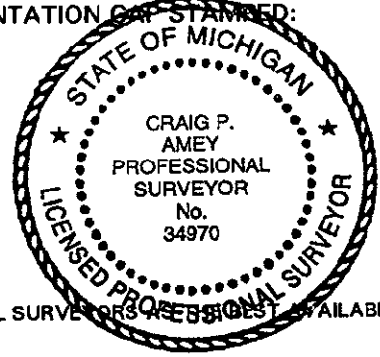

THE SELECTED LOCATION IS ACCEPTED BY ME AND IS GENERALLY ACCEPTED BY PROFESSIONAL SURVEYORS AS THE BEST AVAILABLE EVIDENCE OF THE POSITION OF THE ORIGINAL CORNER.

Signed by *Craig P. Amey* Date 12.15.94
 Surveyor's Michigan License No. 34970