

LAND CORNER RECORDATION CERTIFICATE
Filing Requirement of Act 74, Mich. P.A. 1970

For corners in

<u>MACOMB</u> (County)	Located in: Macomb Township	Corner Code #
1. Public Land Survey	T <u>3N</u> R <u>13E</u>	<u>D-13</u>
	T _____ R _____	_____
	T _____ R _____	_____
	T _____ R _____	_____
2. Property Controlling in Section	S _____ T _____ R _____	<u>Log #2 pm</u>
	S _____ T _____ R _____	_____
3. Miscellaneous Property in Sec.	S _____ T _____ R _____	_____
	S _____ T _____ R _____	_____
4. Lot No. _____, Recorded Plat _____		
5. Private Claims _____		

Register of Deeds Stamp & File Number

I, Randy Kolehouse, in a field survey on November 20 19 94, do hereby certify that under requirements of P.A. 74 Michigan P.A. of 1970, the corner points mentioned in lines 1 and 2 above were in conformance with regulations and rules therefore as required in the current manual of survey instructions of the United States Department of the Interior, Bureau of Land Management or by a decree of a Court of Law and/or that the corner points mentioned in lines 3, 4 and 5 above were in conformance with the rules of the Michigan Board of Land Surveyors or by a Decree of a Court of Law; established, re-established, monumented, re-monumented, recovered, found as expressed below:

NOTE: Not more than 4 corners, all in the same town and range, may be recorded on this certificate.

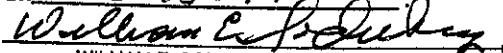
A. Description of original monument and accessories and/or subsequent restoration:

D-13	1817	G.L.O. Notes	Preston	N/A	Post
	1978	L.C.R.C. L. 2940 P. 350	Patterson	#17631	P.K. Nail
	1987	L.C.R.C. L. 4723 P. 608	Donnelly	#21563	P.K. Nail
		Not Recorded Until 1989			
	1988	MDOT Notes	N/A	N/A	P.K. Nail
	1993	L.C.R.C. L. 6166 P. 014	Antcliff	#25826	5/8" Rebar w/Remon. Cap

B. Description of corner evidence found and/or method applied in restoring or reestablishing corner:

D-13 Previous remonumentation iron and cap has been destroyed during M-59 reconstruction. Reset 3/4" iron rod in an existing monument box using the following witness. Also checks closely to the following recorded distance.

L.C.R.C. L.6166 P. 014
 MDOT Nail & Tag W Face P. Pole S 06° W 58.29'
 MDOT Nail & Tag NW Face 4" Elm S 53° W 89.52'
 P.K. NW Face P. Pole S 73° W 158.88'

ACCEPTED BY THE MACOMB COUNTY SURVEY PEER GROUP AS THE OFFICIAL CORNER UNDER MICHIGAN PUBLIC ACT 345 OF 1990 AT A MEETING HELD ON 12-17-94

 WILLIAM E. SODERBERG, P.S., CHAIRMAN

Measures East to E-13 = 2670.86 (MDOT Plans = 2670.53') (MDOT 1988 = 2670.82') (WWES 1994 = 2670.76')
 Measures East to D-1 T2N R13E = 597.17' (WWES 1994 = 597.13')
 Measures West to C-1 T2N R13E = 2080.18' (AEW 1992 = 2080.14') (WWES 1994 = 2080.17') (MDOT = 2080.13')
 Measures West to C-13 = 2675.04' (MDOT Plans = 2675.09') (AEW 1992 = 2675.01') (WWES 1994 = 2675.02')

C. Description of monument for corner and accessories established to perpetuate locating the position of the corner:

D-13 I set a 3/4" x 24" iron rod w/2" diameter aluminum cap stamped "Macomb County Monument MI Act 345 #25854" in an existing monument box.

PK & Macomb Co. Remon. Tag Top Curb N Side E.B. M-59 N 40° E 15.19'
 PK & Macomb Co. Remon. Tag NE Face 8" Elm S 48° E 97.90'
 Nail w/MDOT Tag W. Face Util. Pole S 06° W 58.29'
 Nail w/MDOT Tag NW Face 4" Elm S 53° W 89.52'
 P.K. NW Face Util. Pole S 73° W 158.88'

The selected location is accepted by me and is generally accepted by professional surveyors as the best available evidence of the position of the original corner.

Signed by Randy J. Kolehouse Date 12/16/94
 Surveyor's Michigan License No. 25854

