


Chesterfield Township T3N, R14E

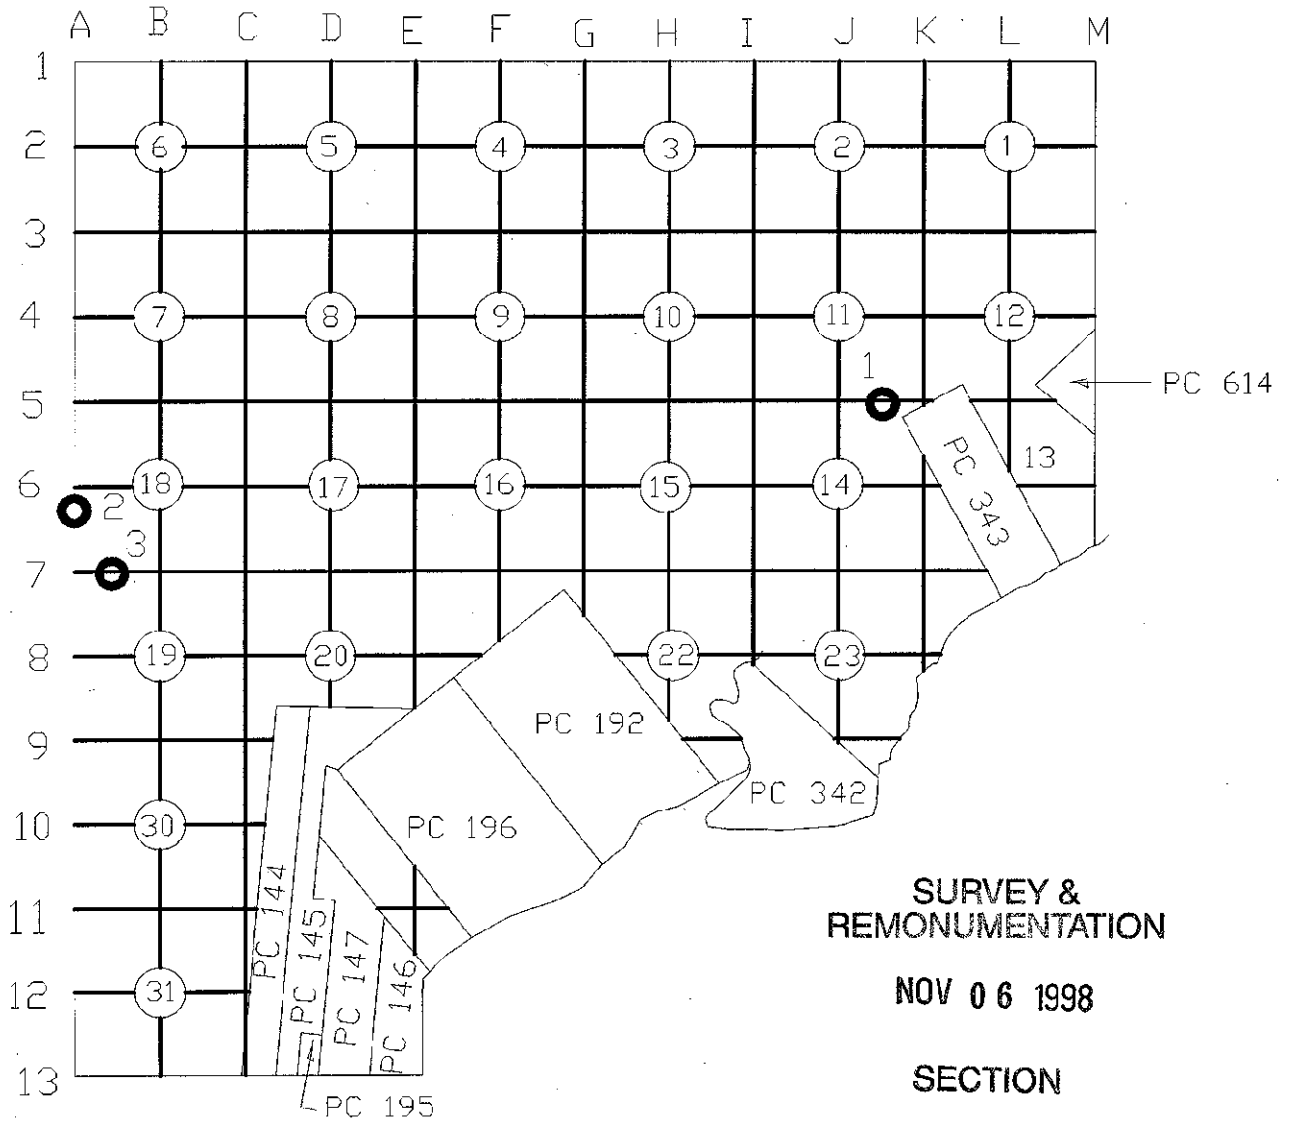

- 1 = BETWEEN J-5 AND K-5 L 6166 P 002 #810
- 2 = SOUTH OF A-6 L 6862 P 843 #805
- 3 = BETWEEN A-7 AND B-7 L6862 P 841 #809