

# SURVEY & REMONUMENTATION

APR 28 1995

C0158341 LIBER:06543 PAGE:363 08:35A 01/05/1995  
CARMELLA SABAUGH-MACOMB COUNTY, MI REG/DEEDS

## COMMISSION

### LAND CORNER RECORDATION CERTIFICATE Filing Requirement of Act 74, Mich. P.A. 1970

For corners in

<u>MACOMB</u>	Located in:	Corner Code #	
(County)	<b>CHESTERFIELD TOWNSHIP</b>		
1. Public Land Survey	T <u>3N</u> R <u>14E</u>	<u>A-10</u>	
	T _____ R _____	_____	
	T _____ R _____	_____	
	T _____ R _____	_____	
2. Property Controlling in Section	S _____ T _____ R _____	_____	
	S _____ T _____ R _____	_____	
3. Miscellaneous Property in Sec.	S _____ T _____ R _____	_____	
	S _____ T _____ R _____	_____	

Register of Deeds Stamp & File Number

4. Lot No. \_\_\_\_\_, Recorded Plat \_\_\_\_\_  
5. Private Claims \_\_\_\_\_

I, CRAIG P. AMEY, in a field survey on MAY 25, 19 94 do hereby certify that under requirements of P.A. 74, Michigan P.A. of 1970, the corner points mentioned in lines 1 and 2 above were in conformance with regulations and rules therefore as required in the current manual of survey instructions of the United States Department of the Interior, Bureau of Land Management or by a decree of a Court of Law and /or that the corner points mentioned in lines 3, 4 and 5 above were in conformance with the rules of the Michigan Board of Land Surveyors or by a Decree of a Court of Law; established, re-established, monumented, re-monumented, recovered, found as expressed below:

	A	B	C	D	E	F	G	H	I	J	K	L	M
1													
2	6		5		4		3		2		1		
3													
4	7		8		9		10		11		12		
5													
6	18		17		16		15		14		13		
7													
8	19		20		21		22		23		24		
9													
10	30		29		28		27		26		25		
11													
12	31		32		33		34		35		36		
13													

**NOTE: Not more than 4 corners, all in the same town and range, may be recorded on this certificate.**

A. Description of original monument and accessories and/or subsequent restoration:

G.L.O. (1817)	WILLIAM PRESTON	NO WITNESSES REMAIN
SURVEY (1980) LIBER 3293 PAGE 828	WILLIAM E. SODERBERG #17635	FOUND 3/4" PIPE IN MONUMENT BOX

CORNER IS COMMON TO M-10, T.3N., R.14E., MACOMB COUNTY

B. Description of corner evidence found and/or method applied in restoring or reestablishing corner:

FOUND 3/4" PIPE ADJACENT TO CONCRETE POST (MONUMENT BOX GONE)  
THIS CORNER VERIFIED BY: FOUND AND MATCHED ALL EXISTING RECORDED WITNESSES.


SURVEY LIBER 3293 PAGE 828	
S 41° W	10.93' FOUND 26" ELM (NOW A STUMP)
S 76° W	20.97' FOUND 12" TWIN OAK
WEST	00.20' FOUND CONCRETE POST
NORTH 2668.47' NORTHWEST CORNER OF SECTION 25 (M-9)	
SOUTH 2684.51' SOUTHWEST CORNER OF SECTION 25 (M-11)	

ACCEPTED BY THE MACOMB COUNTY SURVEY PEER GROUP AS THE OFFICIAL CORNER UNDER MICHIGAN PUBLIC ACT 345 OF 1990 AT A MEETING HELD ON 9-27-94  
*William E. Soderberg*  
WILLIAM E. SODERBERG, P.S., CHAIRMAN

C. Description of monument for corner and accessories established to perpetuate locating the position of the corner:

REPLACED 3/4" PIPE WITH A 3/4" x 24" IRON AND A MACOMB COUNTY REMONUMENTATION CAP STAMPED:  
"MACOMB COUNTY MONUMENT"  
"34970"  
"MI ACT 345"

005°	2.75'	SET A CHISELED "X" ON THE WEST FACE OF A FENCE POST
100°	83.85'	SET A PK ON A CONCRETE JOINT IN UTICA STEEL PARKING LOT
175°	27.80'	SET A PK AND MCR TAG IN THE WEST FACE OF A 13" ASH
248°	29.00'	SET A PK AND MCR TAG IN THE WEST FACE OF A 15" OAK

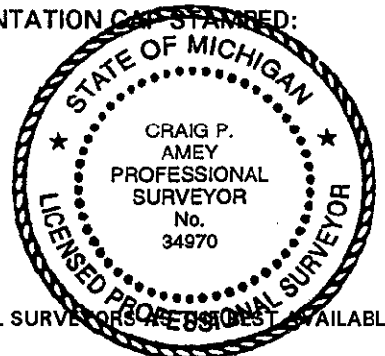

THE SELECTED LOCATION IS ACCEPTED BY ME AND IS GENERALLY ACCEPTED BY PROFESSIONAL SURVEYORS AS THE BEST AVAILABLE EVIDENCE OF THE POSITION OF THE ORIGINAL CORNER.

Signed by *C. P. Amey* Date 12-15-94  
Surveyor's Michigan License No. 34970