

**SURVEY &
REMONUMENTATION**

**LAND CORNER RECORDATION CERTIFICATE
Filing Requirement of Act 74, Mich. P.A. 1970**

APR 07 1998

For corners in

Macomb
(County)

Located In: Chesterfield Twp. Corner Code #

SECTION


| | | | | |
|------------------------------------|---|--------------|---------------|------------|
| 1. Public Land Survey | | <u>T-3-N</u> | <u>R-14-E</u> | <u>B-3</u> |
| | | T | R | |
| | | T | R | |
| | | T | R | |
| 2. Property Controlling in Section | S | T | R | |
| | S | T | R | |
| 3. Miscellaneous Property in Sec. | S | T | R | |
| | S | T | R | |

Register of Deeds Stamp & File Number

4. Lot No. _____, Recorded Plat _____

5. Private Claims _____

I, John N. Redash, in a field survey on October 16, 1997 do hereby state that under requirements of P.A. 74, Michigan P.A. of 1970, the corner points mentioned in lines 1 and 2 above were in conformance with regulations and rules therefore as required in the current manual of survey instructions of the United States Department of the Interior, Bureau of Land Management or by a decree of a Court of Law and for that the corner points mentioned in lines 3, 4 and 5 above were in conformance with the rules of the Michigan Board of Land Surveyors or by a Decree of a Court of Law; established, re-established, monumented, recovered, found as expressed below:

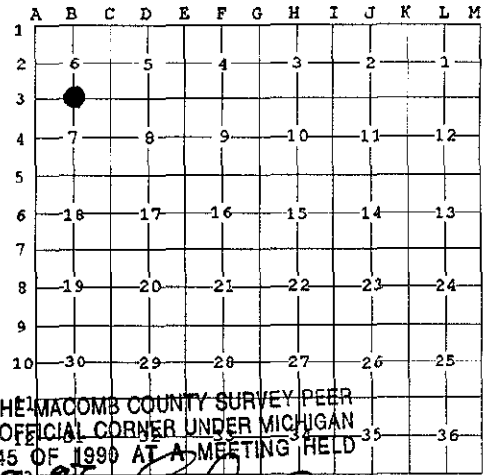

NOTE: Not more than 2 corners, all in the same town and range, may be recorded on this certificate.

ACCEPTED BY THE MACOMB COUNTY SURVEY PEER GROUP AS THE OFFICIAL CORNER UNDER MICHIGAN PUBLIC ACT 345 OF 1990 AT A MEETING HELD ON 11-18-97

William E. Soderberg
WILLIAM E. SODERBERG, P.S., CHAIRMAN

A. Description of original monument and accessories and/or subsequent restoration:

| | | | | | |
|------|---------------|--------------|------------|--------|-------------|
| 1817 | Set post | G.L.O. Notes | W. Preston | N/A | N/A |
| 1980 | 1/2" rod | Survey | R. Kreger | #24601 | L3278, P169 |
| 1983 | 5/8" Iron bar | L.C.R.C. | H. Kobs | #14097 | L3465, P178 |
| 1983 | 1/2" Iron | Survey | H. Kobs | #14097 | L3465, P177 |
| 1986 | 5/8" Iron bar | Survey | H. Kobs | #14097 | L4220, P471 |
| 1987 | 5/8" Iron | L.C.R.C. | H. Kobs | #14097 | L4220, P492 |
| 1993 | 5/8" Iron bar | L.C.R.C. | G. Platz | #38121 | L6185, P653 |
| 1995 | 1/2" Iron bar | Survey | D. King | #30085 | L6595, P773 |

B. Description of corner evidence found and/or method applied in restoring or reestablishing corner:

A 1/2" Iron in gravel road at the intersection of Zulke Road and 25 Mile Road currently occupies this corner. The following witness ties were used to recover and verify its position; current measurements match 3 ties from L.C.R.C. L3465, P178, Survey L4220, P471, and L.C.R.C. L4220, P492; while current measurements match 5 ties from L.C.R.C. L6185, P653. Field observations were obtained between the following corners;

| | | | |
|------------|---------------------------------|------------|---------------------------------|
| B-3 to C-3 | 2669.59 meas. | B-3 to A-3 | 2764.70 meas. |
| | 2669.58 Rec. Survey L4220, P471 | | 2761.85 Rec. Survey L6595, P773 |
| | | | 2756.79 Rec. Survey L3278, P169 |

C. Description of monument for corner and accessories established to perpetuate locating the position of the corner:

I removed the existing 1/2" iron in gravel road and placed a 3/4" X 24" iron rod with a 2" aluminum cap stamped "Macomb County Monument MI Act 345 #37281" in its position. Witness ties are as follows:

| | | |
|-----------|--------|---|
| N. 35° E. | 26.83' | P.K. Nail and Macomb County Remon. washer W. face fence post |
| N. 81° E. | 87.29' | P.K. Nail and Macomb County Remon. washer S. face 18" Maple |
| S. 58° W. | 40.51' | P.K. Nail and Macomb County Remon. washer N. face triple 8" Ash |
| S. 76° W. | 71.92' | P.K. Nail and Macomb County Remon. washer N.W. face 6" Elm |
| N. 29° W. | 56.87' | P.K. Nail and Macomb County Remon. washer S.W. face U-pole |



The selected location is accepted by me and generally accepted by Professional Surveyors as the best available evidence of the position of the original corner.

Signed by *John N. Redash*
Surveyor's Michigan License No. 37281

Date December 16, 1997

705