

**SURVEY &  
REMONUMENTATION**

APR 29 1996

**COMMISSION**

**LAND CORNER RECORDATION CERTIFICATE  
Filing Requirement of Act 74, Mich. P.A. 1970**

For corners in

<u>MACOMB</u> (County)	Located In: <b>CHESTERFIELD TOWNSHIP</b>	Corner Code # <b>B-7</b>
1. Public Land Survey	T <u>3N</u> R <u>14E</u>	<u>B-7</u>
	T ___ R ___	_____
	T ___ R ___	_____
	T ___ R ___	_____
2. Property Controlling in Section	S ___ T ___ R ___	_____
	S ___ T ___ R ___	_____
3. Miscellaneous Property in Sec.	S ___ T ___ R ___	_____
	S ___ T ___ R ___	_____

ACCEPTED BY THE MACOMB COUNTY SURVEY PEER GROUP AS THE OFFICIAL CORNER UNDER MICHIGAN PUBLIC ACT 345 OF 1990 AT A MEETING HELD ON 8-13-95  
*William E. Soderberg*  
WILLIAM E. SODERBERG, P.S., CHAIRMAN

Register of Deeds Stamp & File Number

4. Lot No. \_\_\_\_\_, Recorded Plat \_\_\_\_\_  
5. Private Claims \_\_\_\_\_

I, CRAIG P. AMEY, in a field survey on December 12, 1995 do hereby certify that under requirements of P.A. 74, Michigan P.A. of 1970, the corner points mentioned in lines 1 and 2 above were in conformance with regulations and rules therefore as required in the current manual of survey instructions of the United States Department of the Interior, Bureau of Land Management or by a decree of a Court of Law and/or that the corner points mentioned in lines 3, 4 and 5 above were in conformance with the rules of the Michigan Board of Land Surveyors or by a Decree of a Court of Law; established, re-established, monumented, re-monumented, recovered, found as expressed below:

A	B	C	D	E	F	G	H	I	J	K	L	M
1												
2	6		5		4		3		2		1	
3												
4	7		8		9		10		11		12	
5												
6	18		17		16		15		14		13	
7												
8	19		20		21		22		23		24	
9												
10	30		29		28		27		26		25	
11												
12	31		32		33		34		35		36	
13												

**NOTE: Not more than 4 corners, all in the same town and range, may be recorded on this certificate.**


A. Description of original monument and accessories and/or subsequent restoration:

GLO 1824	Pages 60	William M. Preston	No witnesses found
LCRC 1980	L 3217 P 666	Herbert J. Kobs, #14097	Found, 1/2" Iron bar
Survey 1990		Steven E. Dunn, #28408	Found Pk nail
LCRC 1990	L 4990 P 166	Steven E. Dunn, #28408	Found, 1/2" I. Rod
LCRC 1990		Frank J. Dedecker, #8386	Found, 1/2" Iron rod 0.3' below pavement and
		0.6' north of the centerline of 23 mile	
LCRC 1991	L 5024 P 938	Frank J. Dedecker, #8386	Found, 1/2" Iron rod 0.3' below pavement and
		0.6' north of the centerline of 23 mile	
Survey 1993		William E. Soderberg, #17635	Found 1/2" iron rod

B. Description of corner evidence found and/or method applied in restoring or reestablishing corner:

Found 1/2" iron 0.5' below the surface of 23 mile road (asphalt)  
This corner verified by: Found and matched existing witnesses.

LCRC 1990	43° 54.13'	Found pk nail w/SDA tag in northwest face of utility pole
	134° 63.77'	Found pk nail w/SDA tag in southwest face of utility pole
	221° 77.22'	Found pk nail w/SDA tag in northwest face of utility pole
Survey 1990	NW 69.44'	Found nail in east side of 8" maple
	SE 63.76'	Found form nail in southwest side utility pole
LCRC		L 3217 P 666
	NE 54.08'	Found form nail in utility pole
	SE 63.78'	Found form nail in utility pole

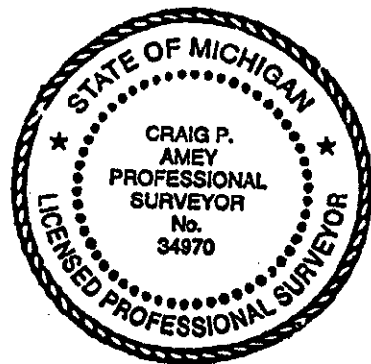

C. Description of monument for corner and accessories established to perpetuate locating the position of the corner:  
Replaced 1/2" iron with A 3/4" x 24" pipe in Mon Box, and a Macomb County Remonumentation cap stamped:

		"MACOMB COUNTY MONUMENT" "34970" "MI ACT 345"
AZ 43° 54.13'		Found a PK nail w/SDA tag in northwest face of utility pole
AZ 130° 92.00'		Set a PK nail and MCR tag in the southwest face of a utility pole
AZ 235° 85.95'		Set a PK nail and MCR tag in the northwest face of utility pole
AZ 335° 69.38'		Set a PK nail and MCR tag in the east side of an 8" maple

The selected location is accepted by me and is generally accepted by Professional Surveyors as the best available evidence of the position of the original corner

Signed by *C. P. Amey* Date 12.18.95  
Surveyor's Michigan License No. 34970