

LAND CORNER RECORDATION CERTIFICATE
Filing Requirement of Act 74, Mich. P.A. 1970

For corners in

Macomb
 (County)

Located In: Chesterfield Twp. Corner Code #


**SURVEY &
 REMONUMENTATION**

MAR 15 1999

SECTION

Register of Deeds Stamp & File Number

- | | | | |
|------------------------------------|-------|--------|-----|
| 1. Public Land Survey | T-3-N | R-14-E | C-2 |
| | T | R | |
| | T | R | |
| | T | R | |
| 2. Property Controlling in Section | S | T | R |
| | S | T | R |
| 3. Miscellaneous Property in Sec. | S | T | R |
| | S | T | R |

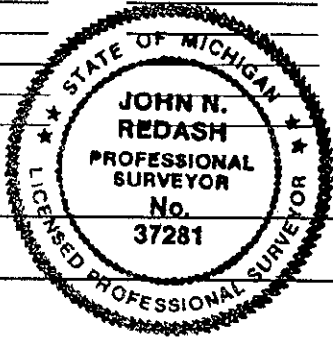

4. Lot No. _____, Recorded Plat _____

5. Private Claims _____

A	B	C	D	E	F	G	H	I	J	K	L	M
1												
2	6	5		4		3		2		1		
3												
4	7		8		9		10		11		12	
5												
6	16		17		16		15		14		13	
7												
8	19		20		21		22		23		24	
9												
10	30		29		28		27		26		25	
11												
12	31		32		33		34		35		36	
13												

I, John N. Redash, in a field survey on Jan. 6, 1998 do hereby state that under requirements of P.A. 74, Michigan P.A. of 1970, the corner points mentioned in lines 1 and 2 above were in conformance with regulations and rules therefore as required in the current manual of survey instructions of the United States Department of the Interior, Bureau of Land Management or by a decree of a Court of Law and /or that the corner points mentioned in lines 3, 4 and 5 above were in conformance with the rules of the Michigan Board of Land Surveyors or by a Decree of a Court of Law; established, re-established, monumented, recovered, found as expressed below:

NOTE: Not more than 2 corners, all in the same town and range, may be recorded on this certificate.

A. Description of original monument and accessories and/or subsequent restoration:

1817	4" dia. iron wood	G.L.O. Notes	W. Preston	N/A	N/A
1972	Found 1/2" dia. rerod	L.C.R.C.	C. Melching	#14767	L2336, P402
1972	Found 1/2" rerod	Survey	C. Melching	#14767	L2336, P435
1976	Found 1/2" iron	Survey	R. Smith	#16052	L2715, P767
1976	Found 1/2" iron	Survey	R. Smith	#16052	L2715, P769
1979	Found 1/2" iron	Survey	G. Avendt	#16034	L3123, P248

B. Description of corner evidence found and/or method applied in restoring or reestablishing corner:

A 1/2" iron rod in the centerline of Hagan Road (gravel) currently occupies this corner. The following witness ties were used to recover and verify its position: Two ties match current measurements from L.C.R.C. L2336, P402. Field measurements were obtained between the following corners:

C-3 to C-2
 2696.49 Meas.
 2640.00 Rec. G.L.O.

ACCEPTED BY THE MACOMB COUNTY SURVEY PEER GROUP AS THE OFFICIAL CORNER UNDER MICHIGAN PUBLIC ACT 345 OF 1990 AT A MEETING HELD ON 10/27/98

William E. Soderberg
 WILLIAM E. SODERBERG, P.S., CHAIRMAN

C. Description of monument for corner and accessories established to perpetuate locating the position of the corner:

I replaced the 1/2" iron rod with a 3/4" X 24" iron rod with a 2" aluminum cap stamped "Macomb County Monument MI Act 345 #37281" in a gravel road with evidence of tree lines to the North and South. Witnesses are as follows:

- AZ. 75° 65.39' Set P.K. nail and Macomb County Remon. tag in S. face Twin 14" Cherry
- AZ. 110° 98.11' Set P.K. nail and Macomb County Remon. tag in N. face utility pole
- AZ. 186° 33.00' Found 1/2" iron capped #30085 in tree root
- AZ. 222° 75.01' N.E. corner concrete foundation to house #27000
- AZ. 260° 75.84' Found P.K. nail in S.E. face utility pole

The selected location is accepted by me and generally accepted by Professional Surveyors as the best available evidence of the position of the original corner.

Signed by John N. Redash
 Surveyor's Michigan License No. 37281

Date 12-23-98

FORM APPROVED BY MICHIGAN STATE BOARD OF PROFESSIONAL SURVEYORS, JAN. 28, 1971
 REVISED MAY 14, 1976
 REVISED JAN., 1983
 REVISED OCT., 1985