

LAND CORNER RECORDATION CERTIFICATE

Filing Requirement of Act 74, Mich. P.A. 1970

For corners in

RECORDED IN MACOMB COUNTY  
RECORDS AT: 8:30 A M.

\_\_\_\_\_ Macomb \_\_\_\_\_ Located In: \_\_\_\_\_ Corner Code # \_\_\_\_\_  
 (County) Chesterfield

1. Public Land Survey T 3 N R 14 E C-5  
 T \_\_\_\_\_ R \_\_\_\_\_  
 T \_\_\_\_\_ R \_\_\_\_\_  
 T \_\_\_\_\_ R \_\_\_\_\_

2. Property Controlling S \_\_\_\_\_ T \_\_\_\_\_ R \_\_\_\_\_  
 in Section S \_\_\_\_\_ T \_\_\_\_\_ R \_\_\_\_\_

3. Miscellaneous S \_\_\_\_\_ T \_\_\_\_\_ R \_\_\_\_\_  
 Property in Sec. S \_\_\_\_\_ T \_\_\_\_\_ R \_\_\_\_\_

4. Lot No. \_\_\_\_\_, Recorded Plat \_\_\_\_\_

5. Private Claims \_\_\_\_\_

DEC 28 1993

*Carmella A. ...*  
CLERK - REGISTER OF DEEDS  
MACOMB COUNTY, MICHIGAN

Register of Deeds Stamp & File Number

I, Steven E. Dunn, in a field survey on December 4, 19 93, do hereby certify that under requirements of P.A. 74, Michigan P.A. of 1970, the corner points mentioned in lines 1 and 2 above were in conformance with regulations and rules therefore as required in the current manual of survey instructions of the United States Department of the Interior, Bureau of Land Management or by a decree of a Court of Law and/or that the corner points mentioned in lines 3, 4 and 5 above were in conformance with the rules of the Michigan Board of Land Surveyors or by a Decree of a Court of Law; established, re-established, monumented, re-monumented, recovered, found as expressed below:

NOTE: Not more than 4 corners, all in the same town and range, may be recorded on this certificate.

	A	B	C	D	E	F	G	H	I	J	K	L	M
2	6		5		4		3		2		1		
3													
4	7		8		9		10		11		12		
5													
6	18		17		16		15		14		13		
7													
8	19		20		21		22		23		24		
9													
10	30		29		28		27		26		25		
11													
12	31		32		33		34		35		36		
13													

A. Description of original monument and accessories and/or subsequent restoration:

GLO Post - No evidence of original corner found.  
GLO Original survey performed by Preston 2-18-1818.  
Certificate of Survey: L.5969, P.102 & 103 Donald H. King #30085 August 11, 1993

L.C.R.C.:	L.2898, P.522	Robert L. Smith	#16052	January	4, 1978
	L.3217, P.666	Herbert J. Kobs	#14097	March	17, 1980
	L.4105, P.602	Raymond J. Donnelly	#21563	January	8, 1987
	L.4723, P.618	Raymond J. Donnelly	#21563	September	15, 1989


B. Description of corner evidence found and/or method applied in restoring or reestablishing corner:

C-5 Sec. Cor.  
Found 1/4" Iron Rod. Verified location by checking existing witnesses of above L.C.R.C.'s and distance along North line of Sec. 18 West to 1/4 cor. and compared to Certificate of Survey above.

Replaced with Macomb County Monument Marker #28408 on 3/4" X 24" Iron Rod.

ACCEPTED BY THE MACOMB COUNTY SURVEY PEER GROUP AS THE OFFICIAL CORNER UNDER MICHIGAN PUBLIC ACT 345 OF 1990 AT A MEETING HELD ON 12-15-93

*F. J. Decker*  
**FRANK J. D. DECKER, PS, PE, CHAIRMAN**

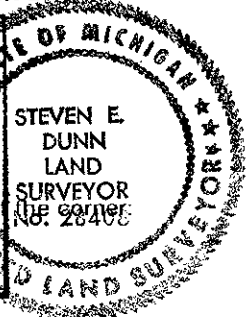

C. Description of monument for corner and accessories established to perpetuate locating the position of

C-5 T.3.N.,R.14E.  
Macomb County Monument Marker #28408 on 3/4" X 24" Iron Rod.

Witnesses:

- N.65°W. 58.15' Found masonry nail and M.C.R.C. tag in concrete base.
- N.37°E. 73.03' Found 1/2" Iron Rod w/cap # 16052.
- N.35°E. 39.67' Found PK nail @ SE face utility pole - replaced with PK nail and Macomb County witness tag.
- S.71°W. 88.05' Found PK nail and SDA. tab #8386 @ North face of utility pole.

The selected location is a careful and faithful perpetuation of the position of the original corner.

Signed by Steven E. Dunn Date 12-20-93

Surveyor's Michigan License No. 28408