

**SURVEY &  
REMONUMENTATION**

**C152289**

**APR 28 1995**

**LAND CORNER RECORDATION CERTIFICATE  
Filing Requirement of Act 74, Mich. P.A. 1970**

94 DEC 14 AM 10:56


**COMMISSION**

corners in

**MACOMB**

(County)

Located In:  
**CHESTERFIELD**

Corner Code #

Public Land Survey	T <u>3N</u> R <u>14E</u>	<u>C-7</u>
	T _____ R _____	_____
	T _____ R _____	_____
	T _____ R _____	_____
Property Controlling in Section	S _____ T _____ R _____	<u>Sec. 1</u>
Miscellaneous	S _____ T _____ R _____	_____
Property in Sec.	S _____ T _____ R _____	_____

LIBER 6527 PAGE 866

Register of Deeds Stamp & File Number

Lot No. \_\_\_\_\_, Recorded Plat \_\_\_\_\_  
Private Claims \_\_\_\_\_

	A	B	C	D	E	F	G	H	I	J	K	L	M
2	6		6		4		3		2		1		
3													
4	7		8		9		10		11		12		
5													
6	8		17		16		15		14		13		
7													
8	18		20		21		22		23		24		
9													
10	30		29		28		27		26		25		
11													
12	31		32		33		34		35		36		
13													

STEVEN E. DUNN, in a field survey on APRIL 4, 19 94, hereby certify that under requirements of P.A. 74, Michigan P.A. of 1970, the corner points mentioned in lines 1 and 2 above were in conformance with regulations and rules therefore required in the current manual of survey instructions of the United States Department of Interior, Bureau of Land Management or by a decree of a Court of Law and /or that the corner points mentioned in lines 3, 4 and 5 above were in conformance with the rules of the Michigan Board of Land Surveyors or by a Decree of a Court of Law; established, established, monumented, re-monumented, recovered, found as expressed below:

**NOTE: Not more than 4 corners, all in the same town and range, may be recorded on this certificate**

Description of original monument and accessories and/or subsequent restoration:

GLO POST - NO EVIDENCE OF ORIGINAL CORNER FOUND  
GLO ORIGINAL SURVEY PERFORMED BY PRESTON 2-18-1818

**CERTIFICATE OF SURVEY**

L. 3217, P. 684 HERBERT J. KOBS, #14097 MARCH 17, 1980  
L. 3265, P. 960 ROBERT L. KREGER, #24601 SEPTEMBER 10, 1980

**L.C.R.C.**

L.C.R.C.	NAME AND NUMBER	DESCRIPTION
L. 3203, P. 361	MYRON L. PETRIE, #19841	FOUND 3/8" IRON BAR
L. 3217, P. 666	HERBERT J. KOBS, #14097	FOUND 3/8" IRON BAR
L. 4487, P. 202	DONALD A. GORMAN, #17622	FOUND 3/8" IRON BAR
L. 4662 P. 740	MARTIN C. DUNN, #30081	NOT LISTED

**DATE**

JANUARY 22, 1980  
MARCH 13, 1980  
AUGUST 8, 1988  
JUNE 12, 1989

Description of corner evidence found and/or method applied in restoring or reestablishing corner:

**C-7 SECTION CORNER**

FOUND 3/8" IRON ROD IN MONUMENT BOX. VERIFIED LOCATION BY COMPARING FOUND WITNESSES OF L.C.R.C.'s AS LISTED BELOW.

**FOUND WITNESSES**

L. 4662 P. 740 N.85°W. 105.91' "+" CUT ON TOP OF SOUTHWEST BOLT OF BASE OF RAILROAD SIGNAL POLE  
S.45°W. 53.47' FORM NAIL AND WASHER IN NORTHWEST FACE OF UTILITY POLE

**FIELD MEASUREMENTS AND RECORDED DISTANCES**

C-7 TO C-6 2429.72 (M.) 2640.00' G.L.O. (R.)  
C-7 TO D-7 2917.25' (M.) 2656.50' G.L.O. (R.)


Description of monument for corner and accessories established to perpetuate locating the position of the corner:

C-7 T.3N., R.14E. I REPLACED 3/8" IRON ROD WITH 3/4" x 24" IRON ROD WITH 2" DIAMETER ALUMINUM CAP AND STAMPED "MACOMB COUNTY MONUMENT MI. ACT 345 #28408" IN AN EXISTING MONUMENT

**WITNESSES**

N.85°W. 105.91' FOUND "+" CUT ON TOP OF SOUTHWEST BOLT OF BASE OF RAILROAD SIGNAL POLE  
S.45°W. 53.47' FOUND FORM NAIL AND WASHER IN NORTHWEST FACE OF UTILITY POLE  
S.40°26'48"E. 55.85' SET PK. NAIL AND M.C.R. TAG IN NORTH FACE OF UTILITY POLE  
N.27°37'31"E. 73.96' SET PK NAIL AND M.C.R. TAG IN NORTHWEST FACE OF UTILITY POLE

THE SELECTED LOCATION IS ACCEPTED BY ME AND PROFESSIONAL SURVEYORS AS THE BEST AVAILABLE EVIDENCE OF THE EVIDENCE OF THE ORIGINAL CORNER.

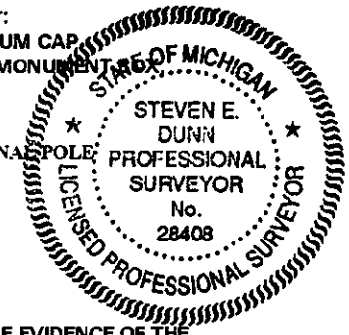

Surveyed by Steven E. Dunn Date Nov. 9, 1994

Surveyor's Michigan License No. 28408