

LIBER 081668057

B999670

LAND CORNER RECORDATION CERTIFICATE RECORDED IN MACOMB COUNTY
Filing Requirement of Act 74, Mich. P.A. 1970 RECORDS AT: 8:30 A.M.

For corners in

MACOMB (County) Located In: Chesterfield Township Corner Code C-10

1. Public Land Survey T 3N R 14E _____
 T _____ R _____
 T _____ R _____
 T _____ R _____

2. Property Controlling in Section S _____ T _____ R _____
 S _____ T _____ R _____

3. Miscellaneous Property in Sec. S _____ T _____ R _____
 S _____ T _____ R _____

4. Lot No. _____, Recorded Plat _____

5. Private Claims _____

DEC 28 1993

Cornelia A. ...
CLERK - REGISTER OF DEEDS
MACOMB COUNTY, MICHIGAN

Register of Deeds Stamp & File Number

A	B	C	D	E	F	G	H	I	J	K	L	M
2	6	5	4	3	2	1						
3												
4	7	8	9	10	11	12						
5												
6	18	17	16	15	14	13						
7												
8	19	20	21	22	23	24						
9												
10	30	29	28	27	26	25						
11												
12	31	32	33	34	35	36						
13												

I, Shelby W. Money, in a field survey on November 18, 19 93, do hereby certify that under requirements of P.A. 74, Michigan P.A. of 1970, the corner points mentioned in lines 1 and 2 above were in conformance with regulations and rules therefore as required in the current manual of survey instructions of the United States Department of the Interior, Bureau of Land Management or by a decree of a Court of Law and/or that the corner points mentioned in lines 3, 4 and 5 above were in conformance with the rules of the Michigan Board of Land Surveyors or by a Decree of a Court of Law; established, re-established, monumented, re-monumented, recovered, found as expressed below:

NOTE: Not more than 4 corners, all in the same town and range, may be recorded on this certificate.

A. Description of original monument and accessories and/or subsequent restoration:

GLO POST. NO WITNESSES REMAIN

MACOMB COUNTY ROAD COMMISSION (1957) UNRECORDED
 FOUND 3/4" PIPE 24.56' NAIL & CAP IN 25" OAK TREE
 N 27' E 26.00' NAIL & CAP IN 12" ELM TREE
 S 19' W 5.04' NAIL & CAP IN 6" ELM TREE

LCRC (1991) L.5286 P.197 SMITH #16052
 FOUND CONCRETE MONUMENT
 WEST 34.51' NORTHEAST CORNER OF CONCRETE SLAB
 NORTH 33.29' 4" CONCRETE MONUMENT
 SOUTH 29.89' PK NAIL IN THE EAST FACE OF A 15" OAK TREE
 EAST 35.08' PK NAIL IN THE SOUTH FACE OF AN 8" ASH TREE

B. Description of corner evidence found and/or method applied in restoring or reestablishing corner:

C-10 FOUND 1/4" REBAR IN 4" SQUARE MONUMENT

THIS CORNER VERIFIED BY:


FOUND ALL WITNESSES
 KLUMPP SUBDIVISION LIBER 33 PAGE 14
 GREENVIEW WOODS ESTATES SUBDIVISION #2 LIBER 83 PAGES 34-36
 EHLER'S SUBDIVISION LIBER 39 PAGE 45
 EHLER'S SUBDIVISION #1 LIBER 41 PAGE 45

C. Description of monument for corner and accessories established to perpetuate locating the position of the corner:

C-10 SET MACOMB COUNTY REMONUMENTATION MARKER #30092 ON TOP OF FOUND MONUMENT
 WITNESSES:
 WEST 34.51' FOUND NORTHEAST CORNER OF CONCRETE SLAB
 NORTH 33.29' FOUND 4" CONCRETE MONUMENT 1/4"D 1/4' REROD
 SOUTH 29.89' FOUND PK NAIL IN THE EAST FACE OF A 15" OAK TREE
 EAST 35.08' FOUND PK NAIL IN THE SOUTH FACE OF AN 8" ASH TREE

ACCEPTED BY THE MACOMB COUNTY SURVEY PEER GROUP AS THE OFFICIAL CORNER UNDER MICHIGAN PUBLIC ACT 345 OF 1990 AT A MEETING HELD ON 12-15-93

F. DeDecker
FRANK J. DeDECKER, P.S., PE, CHAIRMAN

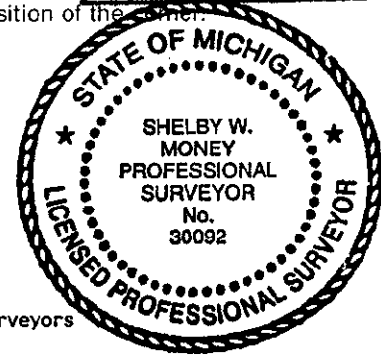

The selected location is accepted by me and is generally accepted by Professional Surveyors as the best available evidence of the position of the original corner.

Signed by Shelby W. Money Date 12/14/93
Surveyor's Michigan License No. 30092