

MAR 17 2000

SECTION

LAND CORNER RECORDATION CERTIFICATE  
Filing Requirement of Act 74, Mich. P.A. 1970

For corners in

MACOMB

(County)

CHESTERFIELD TOWNSHIP

Located In: Corner Code #

- |                                    |                          |            |
|------------------------------------|--------------------------|------------|
| 1. Public Land Survey              | T <u>3N</u> R <u>14E</u> | <u>F-1</u> |
|                                    | T _____ R _____          | _____      |
|                                    | T _____ R _____          | _____      |
|                                    | T _____ R _____          | _____      |
| 2. Property Controlling in Section | S _____ T _____ R _____  | _____      |
|                                    | S _____ T _____ R _____  | _____      |
| 3. Miscellaneous Property in Sec.  | S _____ T _____ R _____  | _____      |
|                                    | S _____ T _____ R _____  | _____      |

ACCEPTED BY THE MACOMB COUNTY SURVEY PEER GROUP AS THE OFFICIAL CORNER UNDER MICHIGAN PUBLIC ACT 345 OF 1990 AT A MEETING HELD ON 10/15/99  
WILLIAM E. GOGGERBERG, P.S., CHAIRMAN

1091810  
LIBER 9267 PAGE 969  
12/27/1999 01:14:47 P.M.  
MACOMB COUNTY, MI  
CARMELLA SABAUGH, REG/DEEDS

Register of Deeds Stamp & File Number

4. Lot No. \_\_\_\_\_, Recorded Plat \_\_\_\_\_  
5. Private Claims \_\_\_\_\_

I, ROBERT H. BIRKETT, in a field survey on JULY 12, 1999 do hereby certify that under requirements of P.A. 74, Michigan P.A. of 1970, the corner points mentioned in lines 1 and 2 above were in conformance with regulations and rules therefore as required in the current manual of survey instructions of the United States Department of the Interior, Bureau of Land Management or by a decree of a Court of Law and /or that the corner points mentioned in lines 3, 4 and 5 above were in conformance with the rules of the Michigan Board of Land Surveyors or by a Decree of a Court of Law; established, re-established, monumented, re-monumented, recovered, found as expressed below:

1	A	B	C	D	E	F	G	H	I	J	K	L	M
2		6		5		4		3		2		1	
3													
4		7		8		9		10		11		12	
5													
6		18		17		16		15		14		13	
7													
8		19		20		21		22		23		24	
9													
10		30		29		28		27		26		25	
11													
12		31		32		33		34		35		36	
13													

NOTE: Not more than 2 corners, all in the same town and range, may be recorded on this certificate.

A. Description of original monument and accessories and/or subsequent restoration:  
F-1 CHESTERFIELD. 1817 W. PRESTON, GLO, SET POST  
(a) 1996, G. JEROME #19837, PK NAIL (PREVIOUSLY FOUND MON. BOX), L.C.R.C. L. 7118, P. 363 M.C.R.

B. Description of corner evidence found and/or method applied in restoring or reestablishing corner:  
F-1 CHESTERFIELD. FOUND 1/2" IRON IN HOLE CENTER OF 26 MILE ROAD (ASPHALT) 0.3' DEEP, WNW - 96.26' - PK NAIL IN NORTHWEST FACE OF A 6" ELM.


<b>FIELD MEASUREMENTS</b>	(SEE BACK FOR SKETCH)		
F-1 TO E-1 CHESTERFIELD	F-1 TO G-1 CHESTERFIELD	F-1 TO E-13 LENOX	F-1 TO F-13 LENOX
GLO (1817) - 40 CHAINS (2640')	GLO (1817) - 40 CHAINS (2640')	GLO (NONE)	GLO (NONE)
NO PRIOR DISTANCES RECORDED	NO PRIOR DISTANCES RECORDED	RE-MON (1999) - 418.19'	RE-MON (1999) - 2314.41'
RE-MON. (1999) - 2676.47'	RE-MON. (1999) - 2759.45'		

C. Description of monument for corner and accessories established to perpetuate locating the position of the corner:  
F-1 CHESTERFIELD  
SET A 3/4" IRON WITH A 2" DIAMETER ALUMINUM CAP STAMPED "MACOMB COUNTY MONUMENT, MI ACT 345, #41904, F-1" NEW MONUMENT BOX, ON LINE BETWEEN E-13 AND F-13 LENOX TOWNSHIP T4N, R14E.

- AZ. 70° 90.72' - SET REMON. TAG IN THE SOUTHEAST FACE OF A UTILITY POLE.
- AZ. 95° 202.55' - SET REMON. TAG IN THE SOUTHWEST FACE OF A UTILITY POLE.
- AZ. 205° 34.00' - SET REMON. TAG IN THE NORTHWEST FACE OF A 7" ELM.
- AZ. 250° 106.80' - FOUND P.K. NAIL WITH TAG #40165 IN THE NORTHWEST FACE OF A DEAD 11" ELM, ABOVE A PLAIN P.K. NAIL
- AZ. 285° 93.73' - SET REMON. TAG IN THE SOUTHWEST FACE OF A UTILITY POLE.

THE SELECTED LOCATION IS ACCEPTED BY ME AND IS GENERALLY ACCEPTED BY PROFESSIONAL SURVEYORS OF THE BEST AVAILABLE EVIDENCE OF THE POSITION OF THE ORIGINAL CORNER.

Signed by Robert H. Birkett Date NOVEMBER 23, 1999  
Surveyor's Michigan License No. 41094

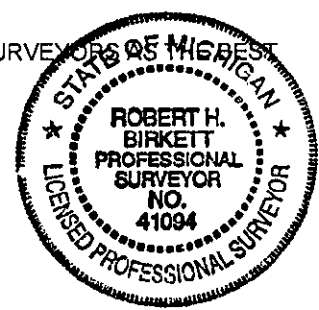

gx ✓

9/18

MAR 17 2000

LIBER 9267 PAGE 970

SECTION

MACOMB COUNTY  
CHESTERFIELD TOWNSHIP  
TOWN 3 NORTH, RANGE 14 EAST

F-1

