

LAND CORNER RECORDATION CERTIFICATE

Filing Requirement of Act 74, Mich. P.A. 1970

For corners in

Macomb
(County)

Located In: Chesterfield Corner Code # F-5

1. Public Land Survey T 3 N. R. 14 E F-5 _____
 T _____ R _____
 T _____ R _____
 T _____ R _____

2. Property Controlling S _____ T _____ R _____
 in Section S _____ T _____ R _____

3. Miscellaneous S _____ T _____ R _____
 Property in Sec. S _____ T _____ R _____

4. Lot No. _____, Recorded Plat _____

5. Private Claims _____

RECORDED IN MACOMB COUNTY
RECORDS AT: 9:30 A M.

DEC 28 1993

Lesonella Avey
CLERK - REGISTER OF DEEDS
MACOMB COUNTY, MICHIGAN

Register of Deeds Stamp & File Number

I, Steven E. Dunn, in a field survey on December 7, 19 93, do hereby certify that under requirements of P.A. 74, Michigan P.A. of 1970, the corner points mentioned in lines 1 and 2 above were in conformance with regulations and rules therefore as required in the current manual of survey instructions of the United States Department of the Interior, Bureau of Land Management or by a decree of a Court of Law and/or that the corner points mentioned in lines 3, 4 and 5 above were in conformance with the rules of the Michigan Board of Land Surveyors or by a Decree of a Court of Law; established, re-established, monumented, re-monumented, recovered, found as expressed below:

NOTE: Not more than 4 corners, all in the same town and range, may be recorded on this certificate.

A. Description of original monument and accessories and/or subsequent restoration:

GL0 Post - No evidence of original corner found.

GL0 Original survey performed by Preston 2-18-1818.


L.C.R.C.: L.4055, P.670 Donald H. King #30085 October 27, 1986
L.5290, P.287 Warren C. Avey #30076 January 6, 1992

B. Description of corner evidence found and/or method applied in restoring or reestablishing corner:

F-5 Found 1/2" Iron Rod in monument box. Found corner matches description and found witnesses of above L.C.R.C.'s.

Replaced with Macomb County Monument Marker #28408 on 3/4" X 24" Iron Rod

ACCEPTED BY THE MACOMB COUNTY
SURVEY PEER GROUP AS THE OFFICIAL
CORNER UNDER MICHIGAN PUBLIC ACT 345
OF 1990 AT A MEETING HELD ON
12-15-93
Frank J. Decker
FRANK J. DODECKER, PS, PE, CHAIRMAN

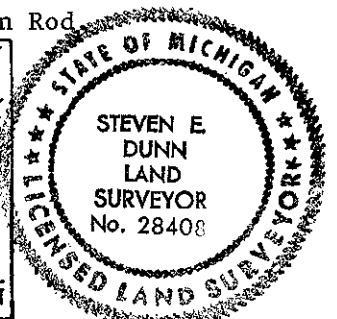

C. Description of monument for corner and accessories established to perpetuate locating the position of the corner.

F-5 T.3N.,R.14E.

Macomb County Monument Marker #28408 on 3/4" X 24" Iron Rod in monument box.

Witnesses:

N.01°W. - 32.95' Found 1/2" Iron Rod w/cap #30092

N.09°W. - 33.45' Found PK nail on East face utility pole. Replaced with PK nail and Macomb County witness tag.

N.50°E. - 45.85' Found scribed "+" on SW rim of gate well.

S.05°W. - 28.45' Found PK nail West face utility pole.

N.09°E. - 45.43' Found PK nail west face 29" maple.

The selected location is a careful and faithful perpetuation of the position of the original corner.

Signed by Steven E. Dunn

Date 12-20-93

Surveyor's Michigan License No. 28408