

LAND CORNER RECORDATION CERTIFICATE  
Filing Requirement of Act 74, Mich. P.A. 1970

MAR 17 2000

For corners in

MACOMB  
(County)

CHESTERFIELD TOWNSHIP  
Located In: Corner Code #

SECTION

1. Public Land Survey	T <u>3</u> N	R <u>14</u> E	<u>G-1</u>
	T ___ R ___		
	T ___ R ___		
	T ___ R ___		
2. Property Controlling in Section	S ___ T ___ R ___		
	S ___ T ___ R ___		
3. Miscellaneous Property in Sec.	S ___ T ___ R ___		
	S ___ T ___ R ___		

1091811  
LIBER 9267 PAGE 971  
12/27/1999 01:14:47 P.M.  
MACOMB COUNTY, MI  
CARMELLA SABAUGH, REG/DEEDS

Register of Deeds Stamp & File Number

4. Lot No. \_\_\_\_\_, Recorded Plat \_\_\_\_\_  
5. Private Claims \_\_\_\_\_

I, ROBERT H. BIRKETT, in a field survey on JULY 12, 1999 do hereby certify that under requirements of P.A. 74, Michigan P.A. of 1970, the corner points mentioned in lines 1 and 2 above were in conformance with regulations and rules therefore as required in the current manual of survey instructions of the United States Department of the Interior, Bureau of Land Management or by a decree of a Court of Law and /or that the corner points mentioned in lines 3, 4 and 5 above were in conformance with the rules of the Michigan Board of Land Surveyors or by a Decree of a Court of Law; established, re-established, monumented, re-monumented, recovered, found as expressed below:

NOTE: Not more than 2 corners, all in the same town and range, may be recorded on this certificate.


1	A	B	C	D	E	F	G	H	I	J	K	L	M
2	6		5			4		3		2		1	
3													
4	7		8			9		10		11		12	
5													
6	18		17			16		15		14		13	
7													
8	19		20			21		22		23		24	
9													
10	30		29			28		27		26		25	
11													
12	31		32			33		34		35		36	
13													

A. Description of original monument and accessories and/or subsequent restoration:  
G-1 CHESTERFIELD.

- 1817, W. PRESTON, GLO, SET POST
- (a) 1993, D. KING #30085, P.K. NAIL, SURVEY, L. 5969, P. 139 MCR.
- (b) 1994, D. KING #30085, P.K. NAIL, L.C.R.C., L. 6586, P. 192 MCR.
- (c) 1996, D. KING #30085, SET P.K. NAIL FROM RECORDS, L.C.R.C., L. 6976, P. 140 MCR.
- (d) 1996, G. PLATZ #38121, P.K. NAIL, L.C.R.C., L. 7359, P. 267 MCR.
- (e) 1996, G. PLATZ #38121, P.K. NAIL, SURVEY, L. 7359, P. 268 MCR.
- (f) 1997, J. WRIGHT #40165, P.K. NAIL, L.C.R.C., L. 7912, P. 850 MCR.

ACCEPTED BY THE MACOMB COUNTY SURVEY PE GROUP AS THE OFFICIAL CORNER UNDER MICHIG PUBLIC ACT 345 OF 1990 AT A MEETING HE ON 10/5/99  
*William E. Soderberg*  
WILLIAM E. SODERBERG, P.S., CHAIRMAN

B. Description of corner evidence found and/or method applied in restoring or reestablishing corner:  
G-1 CHESTERFIELD. FOUND P.K. NAIL IN THE CENTER OF 26 MILE ROAD (ASPHALT)  
NE - (a,b,c 44.96') (d,e, 44.94') - P.K. NAIL IN UTILITY POLE.  
ENE - (d,e 95.83') - CENTERLINE TOP NUT HYDRANT.  
SE - (d,e 43.81') - CENTERLINE TOP NUT HYDRANT.  
W - (a,b,c 444.66') - F-13 LENOX TOWNSHIP.  
WNW - (d,e 193.96') - SET P.K. NAIL WITH TAG #38121 IN SOUTH FACE UTILITY POLE.

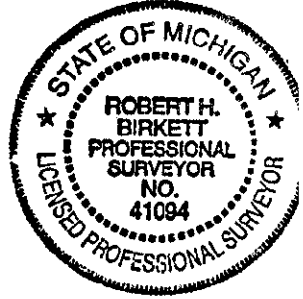

FIELD MEASUREMENTS	(SEE BACK FOR SKETCH)	
G-1 TO F-1 CHESTERFIELD	G-1 TO F-13 LENOX	G-1 TO G-13 LENOX
GLO (1817) - 40 CHAINS (2640')	GLO (NONE)	GLO (NONE)
NO PRIOR DISTANCES RECORDED	REMON (1999) - 445.04'	REMON (1999) - 2279.37'
RE-MON. (1999) - 2759.45"		

C. Description of monument for corner and accessories established to perpetuate locating the position of the corner:  
G-1 CHESTERFIELD  
REPLACED P.K. NAIL AND SET A 3/4" IRON WITH A 2" DIAMETER ALUMINUM CAP STAMPED "MACOMB COUNTY MONUMENT, MI ACT 345, #41094, G-1" IN NEW MONUMENT BOX, ON LINE BETWEEN F-13 AND G-13, T 4 N, R 14 E.

- AZ. 35° 44.90' - SET REMON. TAG ABOVE FOUND P.K. NAIL IN THE NORTHWEST FACE OF A UTILITY POLE.
- AZ. 50° 95.85' - CENTER TOP NUT OF HYDRANT
- AZ. 90° 155.50' - FOUND P.K. NAIL CENTERLINE OF 26 MILE ROAD.
- AZ. 155° 43.86' - CENTER TOP NUT OF HYDRANT.
- AZ. 280° 194.02' - FOUND P.K. NAIL WITH TAG #38121 IN THE SOUTH FACE OF A UTILITY POLE.

THE SELECTED LOCATION IS ACCEPTED BY ME AND IS GENERALLY ACCEPTED BY PROFESSIONAL SURVEYORS AS THE BEST AVAILABLE EVIDENCE OF THE POSITION OF THE ORIGINAL CORNER.

Signed by Robert H. Birkett Date November 23, 1999  
Surveyor's Michigan License No. 41094

91 ✓

019

MACOMB COUNTY  
CHESTERFIELD TOWNSHIP  
TOWN 3 NORTH, RANGE 14 EAST  
G-1

SURVEY &  
REMONUMENTATION

MAR 17 2000

SECTION

