

LAND CORNER RECORDATION CERTIFICATE

Filing Requirement of Act 74, Mich. P.A. 1970

For corners in

Macomb

(County)

Located In: Chesterfield

Corner Code ##

RECORDED IN MACOMB COUNTY

RECORDS AT: 8:30 A.M.

DEC 28 1993

Carrolla A. ... CLERK - REGISTER OF DEEDS MACOMB COUNTY, MICHIGAN

Register of Deeds Stamp & File Number

- 1. Public Land Survey T 3 N R 14 E G-6
2. Property Controlling in Section S T R
3. Miscellaneous Property in Sec. S T R
4. Lot No. Recorded Plat
5. Private Claims


I, Steven E. Dunn, in a field survey on December 7, 1993, do hereby certify that under requirements of P.A. 74, Michigan P.A. of 1970, the corner points mentioned in lines 1 and 2 above were in conformance with regulations and rules therefore as required in the current manual of survey instructions of the United States Department of the Interior, Bureau of Land Management or by a decree of a Court of Law and/or that the corner points mentioned in lines 3, 4 and 5 above were in conformance with the rules of the Michigan Board of Land Surveyors or by a Decree of a Court of Law; established, re-established, monumented, re-monumented, recovered, found as expressed below:

NOTE: Not more than 4 corners, all in the same town and range, may be recorded on this certificate.

A. Description of original monument and accessories and/or subsequent restoration: GLO Post - No Evidence of Original Corner. GLO Original survey performed by Preston 2-18-1818.


- L.C.R.C.'s L.2302, P.916 George J. Avenedt, Jr. #16034 July 7, 1972
L.3644, P.542 Hebert G. Avey #15936 June 28, 1984
L.3945, P.715 Warren C. Avey #30076 May 19, 1986

B. Description of corner evidence found and/or method applied in restoring or reestablishing corner:

G-6 Found 1/2" Iron Rod. Corner Matches Description and Found Witness of above L.C.R.C.'s

Replaced with Macomb County Monument Marker #28408 on 3/4" x 24" Iron Rod

ACCEPTED BY THE MACOMB COUNTY SURVEY PEER GROUP AS THE OFFICIAL CORNER UNDER MICHIGAN PUBLIC ACT 348 OF 1990 AT A MEETING HELD ON 12-15-93 FRANK J. DeDECKER, PS, PE, CHAIRMAN

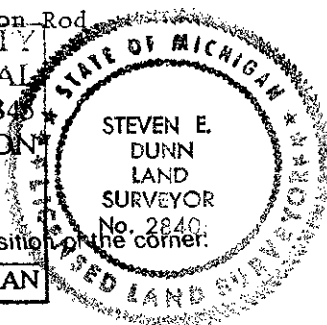

C. Description of monument for corner and accessories established to perpetuate locating the position of the corner:

G-6 T.3N.,R.14 E. Macomb County Monument Marker #28408 on 3/4" x 24" Iron Rod.

- Witnesses: S.83°E. - 20.83' Found Nail and M.C.R.C. Tag in South face Utility Pole. N.79°E. - 30.23' Set P.K. Nail and Macomb County Witness Tag in N. face 12" Poplar. N.25°W. - 41.15' Found 1/2" Iron Rod with Traverse cap. S.32°W. - 44.03 Found Nail and M.C.R.C. Tag in North face Utility Pole.

The selected location is a careful and faithful perpetuation of the position of the original corner.

Signed by Steven E. Dunn Date 12-20-93

Surveyor's Michigan License No. 28408