

LAND CORNER RECORDATION CERTIFICATE
Filing Requirement of Act 74, Mich. P.A. 1970

For corners in

Form with fields for County (Macomb), Located In (Chesterfield), Corner Code (# H-5), and numbered sections 1-5 for survey details.

RECORDED IN MACOMB COUNTY
RECORDS AT: 8:30 A.M.

DEC 28 1993

Register of Deeds Stamp & File Number
Signature of Clerk - Register of Deeds, Macomb County, Michigan

Grid table with columns A-M and rows 2-13, containing numerical values for survey reference.

I, Steven E. Dunn, in a field survey on December 7, 1993, do hereby certify that under requirements of P.A. 74, Michigan P.A. of 1970, the corner points mentioned in lines 1 and 2 above were in conformance with regulations and rules therefore as required in the current manual of survey instructions of the United States Department of the Interior, Bureau of Land Management or by a decree of a Court of Law and/or that the corner points mentioned in lines 3, 4 and 5 above were in conformance with the rules of the Michigan Board of Land Surveyors or by a Decree of a Court of Law; established, re-established, monumented, re-monumented, recovered, found as expressed below:

NOTE: Not more than 4 corners, all in the same town and range, may be recorded on this certificate.

A. Description of original monument and accessories and/or subsequent restoration:

GL0 Post - No evidence of original corner found.
GL0 Original survey performed by Preston 2-18-1818.


L.C.R.C.: L.2342, P.622 Herbert J. Kobs #14097 November 10, 1977
L.5176, P.122 Roger J. Stecker #30103 August 16, 1991

B. Description of corner evidence found and/or method applied in restoring or reestablishing corner:

H-5 Found 1/2" Iron Rod Verified with found Witness of L.C.R.C. - L.5176, P. 12 and Certificate of Survey - L.2342, P. 612

Replaced with Macomb County Monument Marker #28408 on 3/4" x 24" Iron Rod.

ACCEPTED BY THE MACOMB COUNTY SURVEY PEER GROUP AS THE OFFICIAL CORNER UNDER MICHIGAN PUBLIC ACT 345 OF 1990 AT A MEETING HELD ON 12-15-93
Signature of Frank J. Decker, PE, Chairman

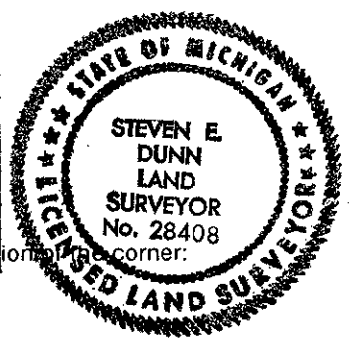

C. Description of monument for corner and accessories and location of the corner:

H-5, T.3N.,R.14E.
Macomb County Monument Marker #28408 on 3/4" X 24" Iron Rod.
Witnesses:
S.45°W. - 46.60' Found 1/2" Iron Rod w/Cap #16052.
S.45°E. - 82.45' Found PK Nail in SW face Utility Pole. Replaced with PK Nail and Macomb County Witness Tag in W. Face 8" Ash.
N.11°E. - 44.80' Set PK Nail and Macomb County Witness Tag.
N.16°W. - 29.55' Found PK Nail in East Face 6" Ash.

The selected location is a careful and faithful perpetuation of the position of the original corner.

Signed by Steven E. Dunn Date 12-20-93
Surveyor's Michigan License No. 28408