

LAND CORNER RECORDATION CERTIFICATE

Filing Requirement of Act 74, Mich. P.A. 1970

For corners in

Macomb (County)

Located In: Chesterfield

Corner Code # I-5

RECORDED IN MACOMB COUNTY RECORDS AT: 8:30 A.M.

DEC 28 1993

Signature of Clerk - Register of Deeds, Macomb County, Michigan

Register of Deeds Stamp & File Number

- 1. Public Land Survey T 3 N R 14 E I-5
2. Property Controlling in Section S T R
3. Miscellaneous Property in Sec. S T R
4. Lot No. Recorded Plat
5. Private Claims

Grid table with columns A-L and rows 2-13. A dot is marked at row 5, column H.

I, Steven E. Dunn, in a field survey on October 24, 1993, do hereby certify that under requirements of P.A. 74, Michigan P.A. of 1970, the corner points mentioned in lines 1 and 2 above were in conformance with regulations and rules therefore as required in the current manual of survey instructions of the United States Department of the Interior, Bureau of Land Management or by a decree of a Court of Law and/or that the corner points mentioned in lines 3, 4 and 5 above were in conformance with the rules of the Michigan Board of Land Surveyors or by a Decree of a Court of Law; established, re-established, monumented, re-monumented, recovered, found as expressed below:

NOTE: Not more than 4 corners, all in the same town and range, may be recorded on this certificate.

A. Description of original monument and accessories and/or subsequent restoration: GLO Post - No evidence of original corner found. GLO Original survey performed by Preston 2-18-1818. Plats: L.67, P.7-10 Birchgrove Subdivision. L.85, P.19-22 Meadowknoll Subdivision.


L.C.R.C.: L.2394, P.61 Robert L. Smith #16052 May 11, 1973
L.3217, P.663 Herbert J. Kobs. #14097 March 17, 1979
L.5176, P.122 Roger J. Stecker #30103 August 16, 1991

B. Description of corner evidence found and/or method applied in restoring or reestablishing corner: I-5 Sec. Cor.

Found 1/2" Iron Rod. Verified location by comparing along West line of Birchgrove Subdivision South to 1/4 corner and along North line of Section 14 East to 1/4 corner on Meadowknoll Subdivision. Checked found witness ties of above L.C.R.C.'s.

Replaced with Macomb County Monument Marker #28408 on 3/4" X 24" Iron Rod.

ACCEPTED BY THE MACOMB COUNTY SURVEY PEER GROUP AS THE OFFICIAL CORNER UNDER MICHIGAN PUBLIC ACT 345 OF 1990 AT A MEETING HELD ON 12-15-93. Signature of Frank J. Decker, P.S., P.E., Chairman.

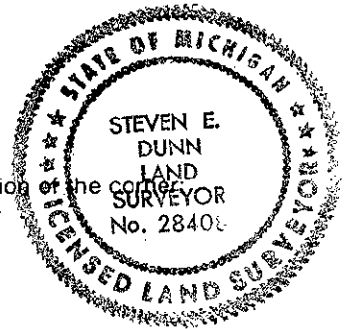

C. Description of monument for corner and accessories re-established, monumented, recovered, found at the corner: I-5 T.3N., R.14E. Macomb County Monument Marker #28408 on 3/4" X 24" Iron Rod. Witnesses:

- N.45°W. 69.55' Found PK nail in East face of 30" Maple.
N.30°E. 33.27' Found PK nail and tag in West face of guy pole.
S.30°E. 53.55' Center of top nut of fire hydrant.
S.45°W. 45.00' Found PK nail in North face of 25" Elm.

The selected location is a careful and faithful perpetuation of the position of the original corner.

Signed by Steven E. Dunn

Date 12-20-93

Surveyor's Michigan License No. 28408