

LIBER 06165 PG 977

B999610

LAND CORNER RECORDATION CERTIFICATE

Filing Requirement of Act 74, Mich. P.A. 1970

For corners in

<u>Macomb</u> (County)	Located In: <u>Chesterfield</u>	Corner Code #: <u>J-5</u>
1. Public Land Survey	T <u>3</u> N R <u>14</u> E	<u>J-5</u>
	T _____ R _____	_____
	T _____ R _____	_____
	T _____ R _____	_____
2. Property Controlling in Section	S _____ T _____ R _____	_____
	S _____ T _____ R _____	_____
3. Miscellaneous Property in Sec.	S _____ T _____ R _____	_____
	S _____ T _____ R _____	_____

RECORDED IN MACOMB COUNTY
RECORDS AT: 8:30 A M.

DEC 28 1993

Carmella F. ...
CLERK - REGISTER OF DEEDS
MACOMB COUNTY, MICHIGAN

Register of Deeds Stamp & File Number

4. Lot No. _____, Recorded Plat _____
5. Private Claims _____

A	B	C	D	E	F	G	H	I	J	K	L	M
2	6	5	4	3	2	1						
3												
4	7	8	9	10	11	12						
5												
6	18	17	16	15	14	13						
7												
8	19	20	21	22	23	24						
9												
10	30	29	28	27	26	25						
11												
12	31	32	33	34	35	36						
13												

I, Steven E. Dumm, in a field survey on December 8, 1993, do hereby certify that under requirements of P.A. 74, Michigan P.A. of 1970, the corner points mentioned in lines 1 and 2 above were in conformance with regulations and rules therefore as required in the current manual of survey instructions of the United States Department of the Interior, Bureau of Land Management or by a decree of a Court of Law and/or that the corner points mentioned in lines 3, 4 and 5 above were in conformance with the rules of the Michigan Board of Land Surveyors or by a Decree of a Court of Law; established, re-established, monumented, re-monumented, recovered, found as expressed below:

NOTE: Not more than 4 corners, all in the same town and range, may be recorded on this certificate.

- A. Description of original monument and accessories and/or subsequent restoration:
 GLO Post - Government Notes call for corner at West Bank of Saline River (A.K.A. Salt River) which matches location of found P.K. on Bridge Deck.
 GLO Original survey performed by Preston 2-18-1818.
 L.C.R.C.: L.3551, P.379 William E. Soderberg #17635 October 13, 1983
 L.4453, P.547 Edward Patrick O'Rourke #16937 July 6, 1988
 L.5158, P.891 Frank DeDecker #8386 July 25, 1991


B. Description of corner evidence found and/or method applied in restoring or reestablishing corner:

J-5 Found P.K. Nail in Bridge Deck which matches corner described and found
Witnesses of above L.C.R.C.'s

Placed Macomb County Monument Marker #28408 in Bridge Deck.

ACCEPTED BY THE MACOMB COUNTY
 SURVEY PEER GROUP AS THE OFFICIAL
 CORNER UNDER MICHIGAN PUBLIC ACT 345
 OF 1990 AT A MEETING HELD ON
12-15-93

Frank J. DeDecker
 FRANK J. DEDecker, PS, PE, CHAIRMAN

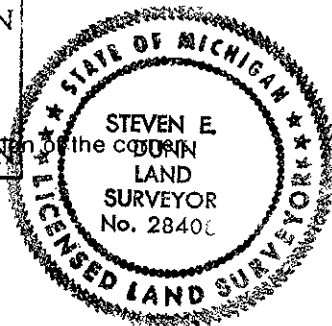

C. Description of monument for corner and accessories and/or subsequent restoration:

- J-5 T.3N., R.14E.
 Macomb County Monument Marker #28408 in Bridge Deck.
 Witnesses:
 WNW - 54.15' Found P.K. Nail top/Wood post for Guardrail.
 WSW - 54.47' Found P.K. Nail top/Wood post for Guardrail.
 ENE - 84.83' Found P.K. Nail South side Wood post for Guardrail.
 ESE - 84.70' Found P.K. Nail South side Wood post for Guardrail.

The selected location is a careful and faithful perpetuation of the position of the original corner.

Signed by Steven E. Dumm Date 12-20-93

Surveyor's Michigan License No. 28408