

LAND CORNER RECORDATION CERTIFICATE

Filing Requirement of Act 74, Mich. P.A. 1970

For corners in

<u>Macomb</u> (County)	Located In: <u>Chesterfield</u>	Corner Code ## _____
1. Public Land Survey	T <u>3</u> N R <u>14</u> E	<u>K-3</u>
	T _____ R _____	_____
	T _____ R _____	_____
	T _____ R _____	_____
2. Property Controlling in Section	S _____ T _____ R _____	_____
	S _____ T _____ R _____	_____
3. Miscellaneous Property in Sec.	S _____ T _____ R _____	_____
	S _____ T _____ R _____	_____

RECORDED IN MACOMB COUNTY
RECORDS AT: 8:30 A M.

DEC 28 1993

Leonelle F. ...
CLERK - REGISTER OF DEEDS
MACOMB COUNTY, MICHIGAN

Register of Deeds Stamp & File Number

- 4. Lot No. _____, Recorded Plat _____
- 5. Private Claims _____

	A	B	C	D	E	F	G	H	I	J	K	L	M
2	6		5		4		3		2		1		
3													
4	7		8		9		10		11		12		
5													
6	18		17		16		15		14		13		
7													
8	19		20		21		22		23		24		
9													
10	30		29		28		27		26		25		
11													
12	31		32		33		34		35		36		
13													

I, Steven E. Dunn, in a field survey on December 8, 19 93, do hereby certify that under requirements of P.A. 74, Michigan P.A. of 1970, the corner points mentioned in lines 1 and 2 above were in conformance with regulations and rules therefore as required in the current manual of survey instructions of the United States Department of the Interior, Bureau of Land Management or by a decree of a Court of Law and/or that the corner points mentioned in lines 3, 4 and 5 above were in conformance with the rules of the Michigan Board of Land Surveyors or by a Decree of a Court of Law; established, re-established, monumented, re-monumented, recovered, found as expressed below:

NOTE: Not more than 4 corners, all in the same town and range, may be recorded on this certificate.

A. Description of original monument and accessories and/or subsequent restoration:

GLO Post - No evidence of original corner found.
GLO Original survey performed by Preston 2-18-1818.

L.C.R.C.: L.2409, P.557 John R. Lansky #18654 June 28, 1973
 L.3168, P.9 Robert L. Smith #16052 October 15, 1979
 L.4662, P.735 Martin C. Dunn #30081 June 12, 1989


B. Description of corner evidence found and/or method applied in restoring or reestablishing corner:

K-3 Found 1/2" Iron Rod which matches description and found
Witnesses of above L.C.R.C.'s

Replaced with Macomb County Monument Marker #28408 on 3/4" X 24" Iron Rod.

ACCEPTED BY THE MACOMB COUNTY
 SURVEY PEER GROUP AS THE OFFICIAL
 CORNER UNDER MICHIGAN PUBLIC ACT 345
 OF 1990 AT A MEETING HELD ON
12-15-93

Frank J. DeDecker
 FRANK J. DeDECKER, PS, PE, CHAIRMAN

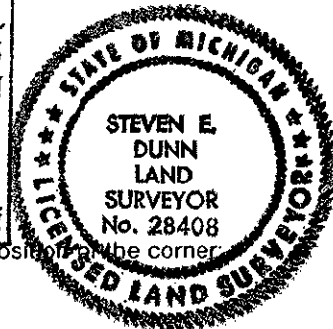

C. Description of monument for corner and accessories established to perpetuate locating the position of the corner

K-3 T.3.N.,R.14E.
 Macomb County Monument Marker #28408 on 3/4" X 24" Iron Rod.
 Witnesses:
 S.35°W. - 20.00' Found PK Nail in NW face 26" Oak.
 N.16°W. - 53.27' Found PK Nail in SW face 23" Oak.
 S.49°E. - 34.05' Found PK Nail and SDA tag #8386 in SW Face 18" Poplar.
 North - 32.85' Found 1/2" Iron Rod and cap #16034

The selected location is a careful and faithful perpetuation of the position of the original corner.

Signed by Steven E. Dunn Date 12-20-93

Surveyor's Michigan License No. 28408