

LAND CORNER RECORDATION CERTIFICATE

Filing Requirement of Act 74, Mich. P.A. 1970

For corners in

Macomb
(County)

Located in:

Chesterfield

Corner Code #

K-7

RECORDED IN MACOMB COUNTY
RECORDS AT: 8:30 A.M.

DEC 28 1993

Carroll A. Fennell
CLERK - REGISTER OF DEEDS
MACOMB COUNTY, MICHIGAN

Register of Deeds Stamp & File Number

- 1. Public Land Survey T 3 N R 14 E
- 2. Property Controlling in Section S T R
- 3. Miscellaneous Property in Sec. S T R

- 4. Lot No. _____, Recorded Plat _____
- 5. Private Claims _____

	A	B	C	D	E	F	G	H	I	J	K	L	M
2	6		5		4		3		2		1		
3													
4	7		8		9		10		11		12		
5													
6	18		17		16		15		14		13		
7													
8	19		20		21		22		23		24		
9													
10	30		29		28		27		26		25		
11													
12	31		32		33		34		35		36		
13													

I, Steven E. Dunn, in a field survey on December 8, 19 93, do hereby certify that under requirements of P.A. 74, Michigan P.A. of 1970, the corner points mentioned in lines 1 and 2 above were in conformance with regulations and rules therefore as required in the current manual of survey instructions of the United States Department of the Interior, Bureau of Land Management or by a decree of a Court of Law and/or that the corner points mentioned in lines 3, 4 and 5 above were in conformance with the rules of the Michigan Board of Land Surveyors or by a Decree of a Court of Law; established, re-established, monumented, re-monumented, recovered, found as expressed below:

NOTE: Not more than 4 corners, all in the same town and range, may be recorded on this certificate.

A. Description of original monument and accessories and/or subsequent restoration:

GL0 Post - No evidence of original corner found.
GL0 Original survey performed by Mullett 3-8-1837

L.C.R.C.:	L.2459, P.591	Robert L. Smith	#16052	December 7, 1973
	L.3026, P.93	Douglas W. Hooth	#7966	November 2, 1978
	L.4132, P.922	John R. Fenn	#23505	February 18, 1987


B. Description of corner evidence found and/or method applied in restoring or reestablishing corner:

K-7 Found Iron Rod with Disc in Monument Box. Found corner follows progression of corner thru above L.C.R.C.'s and found Witnesses.

Replaced with Macomb County Monument Marker #28408 on 3/4" x 24" Iron Rod in Monument Box.

ACCEPTED BY THE MACOMB COUNTY SURVEY PEER GROUP AS THE OFFICIAL CORNER UNDER MICHIGAN PUBLIC ACT 345 OF 1990 AT A MEETING HELD ON 12-20-93

Frank J. Decker
FRANK J. DECKER, P.S., P.E., CHAIRMAN

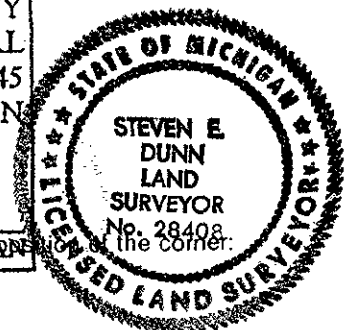

C. Description of monument for corner and accessories and location of the corner:

K-7 T.3.N.,R.14E.
Macomb County Monument Marker #28408 on 3/4" x 24" Iron Rod in Monument Box.
Witnesses:
North - 64.58' to P.K. Nail in East face Utility Pole.
SW - 56.33' to P.K. Nail in East face Utility Pole.
SSE - 40.30' To Center of Storm Manhole.
NE - 111.33' to S.W. Corner of Brick Sign Box.

The selected location is a careful and faithful perpetuation of the position of the original corner.
Signed by Steven E. Dunn Date 12-20-93
Surveyor's Michigan License No. 28408