

**LAND CORNER RECORDATION CERTIFICATE**  
**Filing Requirement of Act 74, Mich. P.A. 1970**

For corners in

MACOMB  
 (County)

**CHESTERFIELD TOWNSHIP**  
 Located In: Corner Code #

1091812  
 LIBER 9267 PAGE 973  
 12/27/1999 01:14:58 P.M.  
 MACOMB COUNTY, MI  
 CARMELLA SABAUGH, REG/DEEDS

- |                                    |  |            |
|------------------------------------|--|------------|
| 1. Public Land Survey              | T <u>3</u> N R <u>14</u> E             | <u>M-2</u> |
|                                    | T <u>   </u> R <u>   </u>              | <u>   </u> |
|                                    | T <u>   </u> R <u>   </u>              | <u>   </u> |
|                                    | T <u>   </u> R <u>   </u>              | <u>   </u> |
| 2. Property Controlling in Section | S <u>   </u> T <u>   </u> R <u>   </u> | <u>   </u> |
|                                    | S <u>   </u> T <u>   </u> R <u>   </u> | <u>   </u> |
| 3. Miscellaneous Property in Sec.  | S <u>   </u> T <u>   </u> R <u>   </u> | <u>   </u> |
|                                    | S <u>   </u> T <u>   </u> R <u>   </u> | <u>   </u> |

**SURVEY & RE-MONUMENTATION**

**MAR 17 2000**

**SECTION**

Register of Deeds Stamp & File Number


4. Lot No. \_\_\_\_\_, Recorded Plat \_\_\_\_\_  
 5. Private Claims \_\_\_\_\_

I, ROBERT H. BIRKETT, in a field survey on JULY 10, 1999 do hereby certify that under requirements of P.A. 74, Michigan P.A. of 1970, the corner points mentioned in lines 1 and 2 above were in conformance with regulations and rules therefore as required in the current manual of survey instructions of the United States Department of the Interior, Bureau of Land Management or by a decree of a Court of Law and /or that the corner points mentioned in lines 3, 4 and 5 above were in conformance with the rules of the Michigan Board of Land Surveyors or by a Decree of a Court of Law; established, re-established, monumented, re-monumented, recovered, found as expressed below:


**NOTE: Not more than 2 corners, all in the same town and range, may be recorded on this certificate.**

A	B	C	D	E	F	G	H	I	J	K	L	M
1												
2	6	5	4	3	2	1						
3												
4	7	8	9	10	11	12						
5												
6	18	17	16	15	14	13						
7												
8	19	20	21	22	23	24						
9												
10	30	29	28	27	26	25						
11												
12	31	32	33	34	35	36						
13												

- A. Description of original monument and accessories and/or subsequent restoration:  
 M-2 CHESTERFIELD 1817 W. PRESTON, GLO, SET WOOD POST  
 (a) 1979, R. SMITH # 16052, 1/2" IRON IN MONUMENT BOX, L.C.R.C., L. 3168, P. 944 M.C.R.  
 (b) 1986, M. ROSSOW # 24615, MON. BOX, SURVEY L. 10, P. 29 S.C.C.R.  
 (c) 1992, R. SMITH # 16052, 1" AXLE SHAFT IN MON. BOX, SURVEY L. 13, P. 236, S.C.C.R.  
 (d) 1992, ST. CLAIR CO. ROAD COMMISSION, MON. BOX, FIELD NOTES..  
 (e) 1993, ST. CLAIR CO. ROAD COMMISSION, MON. BOX, RECORDS.  
 (f) 1997, J. RAUSER #39096, NOT MENTIONED, SURVEY L. 16, P. 387 S.C.C.R.

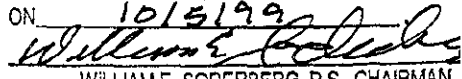ACCEPTED BY THE MACOMB COUNTY SURVEY GROUP AS THE OFFICIAL CORNER UNDER MIC PUBLIC ACT 345 OF 1990 AT A MEETING ON 10/5/99  
  
 WILLIAM E. SODERBERG, P.S., CHAIRMAN

- B. Description of corner evidence found and/or method applied in restoring or reestablishing corner:  
 M-2 CHESTERFIELD. FOUND 5/8" IRON IN MONUMENT BOX CENTER COUNTY LINE ROAD (ASPHALT) .6' DEEP CORNER COMMON TO A-2, IRA TOWNSHIP. T. 3 N., R. 15 E.  
 N.E. - (d 67.58') - SPIKE IN N.W. FACE 18" ASH.  
 S.W. - (a, c 31.98') (b 31.80') - N.E. CORNER CONCRETE HEADWALL  
 N.W. - (a, c 28.04') (b 28.47') (d 28.40') - S.E. CORNER CONCRETE HEADWALL.

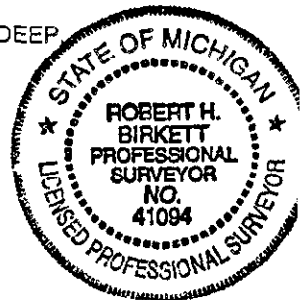

**FIELD MEASUREMENTS**

- |  |  |
|--|--|
| M-2 TO M-1. GLO (1817) - 40 CHAINS (2640') | M-2 TO M-3. GLO (1817) - 40 CHAINS (2640') |
| J. RAUSER (1997) - 2698.66'                | M. ROSSOW (1986) - 2691.34'                |
|  | R. SMITH (1992) - 2691.34'                 |
| RE-MONUMENTATION (1999) - 2698.35'         | RE-MONUMENTATION (1999) - 2691.62'         |

- C. Description of monument for corner and accessories established to perpetuate locating the position of the corner:  
 M-2 CHESTERFIELD. PLACED ON EXISTING IRON A 2" DIAMETER ALUMINUM CAP STAMPED "MACOMB COUNTY MONUMENT, MI ACT 345, #41094, M-2" IN EXISTING MONUMENT BOX.

- AZ . 85° 54.38' - SET REMON. TAG OVER FOUND MAG NAIL IN SOUTH FACE UTILITY POLE.  
 AZ. 95° 32.92' - FOUND 1/2" IRON # 24608.  
 AZ. 215° 67.40' - SET REMON. TAG OVER FOUND P.K. NAIL IN NORTHWEST FACE 20" ASH.  
 AZ. 215° 67.54' FOUND SPIKE IN NORTHWEST ROOT 20" ASH.  
 AZ. 240° 31.95' - NORTHEAST CORNER CONCRETE HEADWALL.  
 AZ. 285° -28.14' - SOUTHEAST CORNER CONCRETE HEADWALL.

THE SELECTED LOCATION IS ACCEPTED BY ME AND IS GENERALLY ACCEPTED BY PROFESSIONAL SURVEYORS AS THE BEST AVAILABLE EVIDENCE OF THE POSITION OF THE ORIGINAL CORNER.

Signed by Robert H. Birkett Date 23 November 1999  
 Surveyor's Michigan License No. 41094