

LAND CORNER RECORDATION CERTIFICATE
Filing Requirement of Act 74, Mich. P.A. 1970

For corners in

MACOMB
 (County)

CHESTERFIELD TOWNSHIP
 Located In: Corner Code #

1091813
 LIBER 9267 PAGE 974
 12/27/1999 01:15:00 P.M.
 MACOMB COUNTY, MI
 CARMELLA SABAUGH, REG/DEEDS

1. Public Land Survey T 3 N R 14 E M-4
- T R
- T R
- T R
2. Property Controlling S T R
 in Section S T R
3. Miscellaneous S T R
 Property in Sec. S T R

SURVEY &
 RE-MONUMENTATION
 MAR 17 2000
 SECTION

Register of Deeds Stamp & File Number

4. Lot No. _____, Recorded Plat _____
 5. Private Claims _____

I, ROBERT H. BIRKETT, in a field survey on JULY 10, 1999 do hereby certify that under requirements of P.A. 74, Michigan P.A. of 1970, the corner points mentioned in lines 1 and 2 above were in conformance with regulations and rules therefore as required in the current manual of survey instructions of the United States Department of the Interior, Bureau of Land Management or by a decree of a Court of Law and /or that the corner points mentioned in lines 3, 4 and 5 above were in conformance with the rules of the Michigan Board of Land Surveyors or by a Decree of a Court of Law; established, re-established, monumented, re-monumented, recovered, found as expressed below:

	A	B	C	D	E	F	G	H	I	J	K	L	M
1													
2		6		5		4		3		2		1	
3													
4		7		8		9		10		11		12	
5													
6		18		17		16		15		14		13	
7													
8		19		20		21		22		23		24	
9													
10		30		29		28		27		26		25	
11													
12		31		32		33		34		35		36	
13													

NOTE: Not more than 2 corners, all in the same town and range, may be recorded on this certificate.

A. Description of original monument and accessories and/or subsequent restoration:

- M-4 CHESTERFIELD 1818 W. PRESTON, GLO, SET WOOD POST
 (a) 1997, M. DUNN #30081, 1" AXLE SHAFT IN MONUMENT BOX, RECORDED PLAT, L. 121, P. 15-23, M.C.R.
 (b) 1995, M. DUNN # 30081, 1" AXLE SHAFT IN MONUMENT BOX, L.C.R.C., L. 6585, P. 862, M.C.R.
 (c) 1995, M. DUNN # 30081, FOUND AXLE SHAFT IN MONUMENT BOX, L.C.R.C., L. 6853, P. 216, M.C.R.

B. Description of corner evidence found and/or method applied in restoring or reestablishing corner:

M-4 CHESTERFIELD. FOUND 1" IRON IN MONUMENT BOX CENTER COUNTY LINE ROAD (ASPHALT) .6' DEEP. CORNER COMMON TO A-4, IRA TOWNSHIP, T3N, R15E.

- N.E. (b, c 147.65') FOUND REGULAR NAIL WITH TAG "RLS 123" IN WEST FACE OF UTILITY POLE.
 S.E. (b, c 70.00') SET P.K. NAIL IN WEST FACE OF UTILITY POLE.
 N. (c 29.92') FOUND IRON ROD IN MONUMENT BOX..

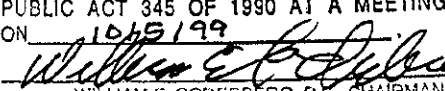
FIELD MEASUREMENTS

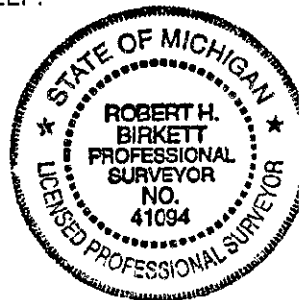
- | | |
|--------------------------------|----------------------------------|
| M-4 TO M-3 | M-4 TO N. LINE P.C. 614 |
| GLO (1817) 40 CHAINS (2640') | GLO (1817) 4.35 CHAINS (287.10') |
| M. DUNN (1995-1997) - 2665.33' | M. DUNN (1995-1997) - 344.56' |
| RE-MON. (1999) -2665.51' | RE-MON. (1999) - 344.43' |

C. Description of monument for corner and accessories established to perpetuate locating the position of the corner:

M-4 CHESTERFIELD. SET A 3/4" IRON WITH A 2" DIAMETER ALUMINUM CAP STAMPED "MACOMB COUNTY MONUMENT, M1 ACT 345, #41094, M-4" IN RAISED MONUMENT BOX .

- AZ 10.° 147.61' - FOUND NAIL WITH TAG #123 IN WEST FACE UTILITY POLE.
 AZ. 135° 70.08' - SET REMON. TAG ABOVE FOUND P.K. NAIL IN WEST FACE UTILITY POLE.
 AZ. 280° 38.91' - FOUND CHISELED "X" ON EAST RIM STORM MANHOLE.
 AZ. 345° 130.50' - SOUTHEAST CORNER CONCRETE HEADWALL.
 AZ. 350° 29.93' - 1/2" IRON IN MONUMENT BOX.

ACCEPTED BY THE MACOMB COUNTY SURVEY GROUP AS THE OFFICIAL CORNER UNDER MICH. PUBLIC ACT 345 OF 1990 AT A MEETING ON 10/5/99

 WILLIAM E. SODERBERG, P.S., CHAIRMAN



THE SELECTED LOCATION IS ACCEPTED BY ME AND IS GENERALLY ACCEPTED BY PROFESSIONAL SURVEYORS AS THE BEST AVAILABLE EVIDENCE OF THE POSITION OF THE ORIGINAL CORNER.

Signed by Robert H. Birkett Date 23 November 1999
 Surveyor's Michigan License No. 41094

921