

LAND CORNER RECORDATION CERTIFICATE
Filing Requirement of Act 74, Mich. P.A. 1970

SURVEY &
REMONUMENTATION

For corners in

MACOMB
(County)

Located In: CHESTERFIELD TOWNSHIP
Corner Code # _____

APR 07 1998

SECTION _____

1. Public Land Survey T 3N R 14E C-7
T _____ R _____
T _____ R _____
T _____ R _____
2. Property Controlling S _____ T _____ R _____
in Section S _____ T _____ R _____
3. Miscellaneous S _____ T _____ R _____
Property in Sec. S _____ T _____ R _____


Register of Deeds Stamp & File Number

4. Lot No. _____, Recorded Plat _____
5. Private Claims _____

I, ROBERT H. BIRKETT, in a field survey on JULY 22, 1997 do hereby certify that under requirements of P.A. 74, Michigan P.A. of 1970, the corner points mentioned in lines 1 and 2 above were in conformance with regulations and rules therefore as required in the current manual of survey instructions of the United States Department of the Interior, Bureau of Land Management or by a decree of a Court of Law and for that the corner points mentioned in lines 3, 4 and 5 above were in conformance with the rules of the Michigan Board of Land Surveyors or by a Decree of a Court of Law; established, re-established, monumented, re-monumented, recovered, found as expressed below:

NOTE: Not more than 2 corners, all in the same town and range, may be recorded on this certificate.

A. Description of original monument and accessories and/or subsequent restoration:
1818, GLO, SET POST
1980, M. PETRIE # 19841, FOUND 3/8" BAR, L.C.R.C. L. 3203, P. 361.
1980, H. KOBS #14097, FOUND 3/8" BAR, L.C.R.C. L. 3217, P.666.
1988, D. GORMAN #17622, FOUND 3/8" BAR, L.C.R.C. L. 4487, P. 202.
1989, M. DUNN #30081, NOT LISTED, L.C.R.C. L. 4662, P. 740.
1993, R. CAMPBELL, R.C.M.C. MONUMENT WITNESS RECORD, 1/2" IRON IN MONUMENT BOX.
1994, S. DUNN #28408, SET MACOMB COUNTY MONUMENT IN EXISTING MONUMENT BOX, L. 6527, P. 866. M.C.R.

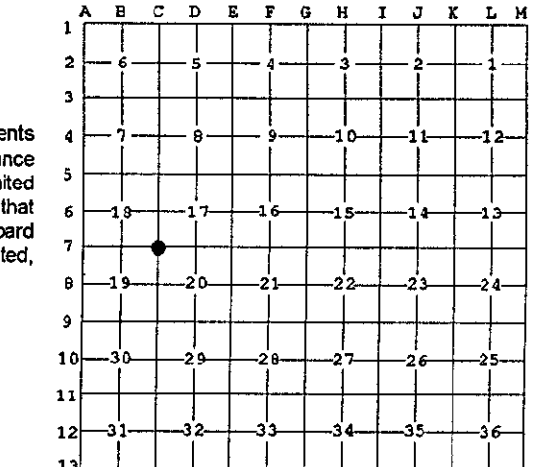

ACCEPTED BY THE MACOMB COUNTY SURVEY PEER GROUP AS THE OFFICIAL CORNER UNDER MICHIGAN PUBLIC ACT 345 OF 1990 AT A MEETING HELD ON 11-4-97
William E. Soderberg
WILLIAM E. SODERBERG, P.S., CHAIRMAN


B. Description of corner evidence found and/or method applied in restoring or reestablishing corner:
FOUND 1/2" RE-ROD IN MONUMENT BOX, CENTERLINE OF RECONSTRUCTED 23 MILE ROAD.
- N.E. 120.20' TO SET P.K. NAIL WITH M.C.R.C. TAG IN CONCRETE SIDEWALK.

DISTANCES FROM L. 6527, P. 866 FIELD GROUND DISTANCES
C-7 TO C-6 2429.72' (2640' GLO) C-7 TO B-7 2604.95'
C-7 TO D-7 2917.25' (2656.50' GLO)

C. Description of monument for corner and accessories established to perpetuate locating the position of the corner:
REMOVED EXISTING 1/2" RE-ROD AND REPLACED WITH 3/4" X 24" IRON WITH 2" DIAMETER ALUMINUM CAP STAMPED "MACOMB COUNTY MONUMENT MI ACT 345 C-7 41094" IN EXISTING MONUMENT BOX.

AZ. 30° - 79.57' - FOUND P.K. NAIL W/TAG #34970 IN SOUTHEAST FACE UTILITY POLE.
AZ. 60° - 12.25' - FOUND P.K. NAIL W/TAG M.C.R.C. IN JOINT OF CONCRETE SIDEWALK.
AZ. 135° - 70.89' - FOUND P.K. NAIL W/TAG #34970 IN NORTHEAST FACE UTILITY POLE.
AZ. 240° - 116.44' - FOUND P.K. NAIL W/TAG #34970 IN NORTHWEST FACE UTILITY POLE WITH LIGHT

THE SELECTED LOCATION IS ACCEPTED BY ME AND IS GENERALLY ACCEPTED BY PROFESSIONAL SURVEYORS AS THE BEST AVAILABLE EVIDENCE OF THE POSITION OF THE ORIGINAL CORNER.

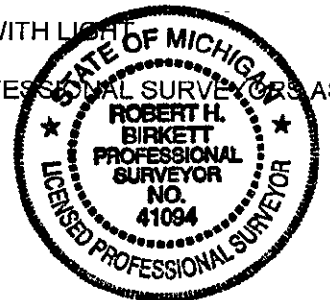

Signed by *Robert H. Birkett* Date 12/19/97
Surveyor's Michigan License No. 41094