

LAND CORNER RECORDATION CERTIFICATE
 Filing Requirement of Act 74, Mich. P.A. 1970

For corners in

Macomb
 (County)

Located in: Washington Township Corner Code #

- | | | | |
|------------------------------------|-------------|--------------|-------------|
| 1. Public Land Survey | T <u>4N</u> | R <u>12E</u> | <u>A-12</u> |
| | T | R | |
| | T | R | |
| | T | R | |
| 2. Property Controlling in Section | S | T | R |
| | S | T | R |
| 3. Miscellaneous Property in Sec. | S | T | R |
| | S | T | R |
4. Lot No. _____ Recorded Plat _____
 5. Private Claims _____

SURVEY & REMONUMENTATION

OCT 19 1998

SECTION

Register of Deeds Stamp & File Number

A	B	C	D	E	F	G	H	I	J	K	L	M
1												
2	6	5	4	3	2	1						
3												
4	7	8	9	10	11	12						
5												
6	18	17	16	15	14	13						
7												
8	19	20	21	22	23	24						
9												
10	30	29	28	27	26	25						
11												
12	31	32	33	34	35	36						
13												

I, Huston K. Kennedy, in a field survey on April 24, 1998 do hereby state that under requirements of P.A. 74, Michigan P.A. of 1970, the corner points mentioned in lines 1 and 2 above were in conformance with regulations and rules therefore as required in the current manual of survey instructions of the United States Department of the Interior, Bureau of Land Management or by a decree of a Court of Law and/or that the corner points mentioned in lines 3, 4 and 5 above were in conformance with the rules of the Michigan Board of Land Surveyors or by a Decree of a Court of Law, established, re-established, monumented, recovered, found as expressed below:

NOTE: Not more than 2 corners, all in the same town and range, may be recorded on this certificate.

A. Description of original monument and accessories and/or subsequent restoration:
 1817-GLO Wampler, D.S.; No post was set
 1.) 1995-Ward, PS #22445; LCRC L15213, Pg.149 (Oakland Twp.) - Set a Concrete Monument w/brass cap #22445

B. Description of corner evidence found and/or method applied in restoring or reestablishing corner:
 1998-Kennedy Surveying, Inc. - Kennedy, PS #17623 - The corner has not been perpetuate, and there are no lines of occupation. Found a 4" diameter Concrete Monument w/2" diameter brass cap stamped Oakland County Remonumentation, PS #22445 at the surface located in between a two lane asphalt road and two lane asphalt bike path in Stony Creek Metropark. This corner is being accepted as the East 1/4 corner of Section 36, T4N, R11E, (M-12) Oakland Township.

HOW THE CORNER WAS RECOVERED

The corner was recovered on a straight line between M-12 and M-11 and set at 1/2 the GLO stagger between M-11 & A-11. The GLO stagger between M-11 & A-11 is 12 links or 7.92 feet and one-half (1/2) = 6 links or 3.96 feet.

Witnesses from LCRC #1 were used to recover and verify the location of the found 4" diameter Concrete Monument w/2" diameter brass cap stamped Oakland County Remonumentation, PS #22445 as the East 1/4 corner of Section 36, T4N, R11E, Oakland Township (M-12).

FIELD MEASUREMENTS BETWEEN

A-12 to A-11
 No GLO
 2649.94 Ft. (GPS-GROUND)

A-12 to M-12
 No GLO
 3.96 Ft. (MEA 1898)

A-12 to A-13
 No GLO
 2647.65 Ft. (GPS-GROUND)

ACCEPTED BY THE MACOMB COUNTY SURVEY PEER GROUP AS THE OFFICIAL CORNER UNDER MICHIGAN PUBLIC ACT 345 OF 1990 AT A MEETING HELD ON 10/20/98
William E. Soderberg
 WILLIAM E. SODERBERG, P.S., CHAIRMAN


(See back side of LCRC for location map)

C. Description of monument for corner and accessories established to perpetuate locating the position of the corner:
 A-12 | set a 4" diameter Concrete Monument with a 1/2" Iron Rod w/2" diameter aluminum cap stamped "Macomb County Monument, MI Act #345" #17623
 N23°W 95.91' Set Mag Nail & Remon Washer SW face 12" Pine
 N39°E 68.32' Set Mag Nail & Remon Washer North face 15" Pine
 S70°E 150.07' Set Mag Nail & Remon Washer NE face 12" Poplar
 N88°W 141.60' Set Mag Nail & Remon Washer NE face 9" Poplar
 South 3.96 feet East 1/4 corner of Section 36, T4N, R11E, Oakland Twp., (M-12)

The selected location is accepted by me and is generally accepted by Professional Surveyors as the best available evidence of the position of the original corner.

Signed by: [Signature]
 Surveyor's Michigan License No. 17623


Date 7-2-98

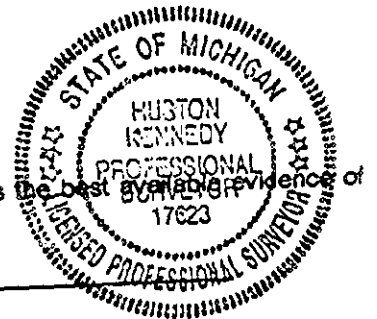

29

STONY CHEEK METROPARK

4300 MAIN PARK RD., SHELBY TWP., MICHIGAN 48316 TELEPHONE: 781-4242
OUTSIDE LOCAL DIALING AREA: 1-800-47-PARKS

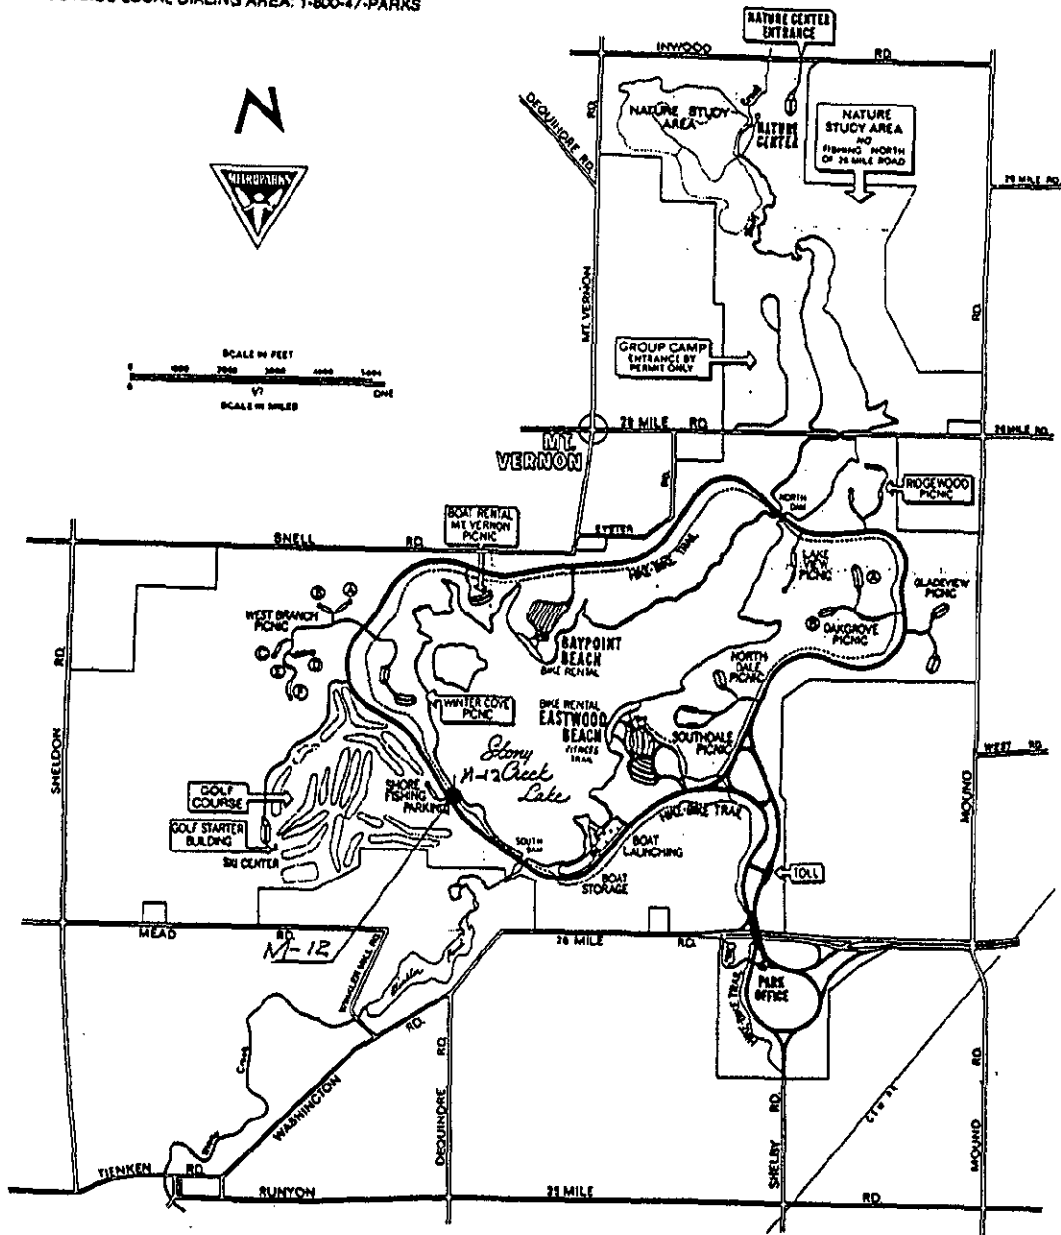

C0738453 LIBER:08156 PAGE:822 09:45A 07/20/1998
CARMELLA SABAUGH-MACOMB COUNTY, MI REG/DEEDS

SURVEY &
REMONUMENTATION

OCT 19 1998

SECTION