

For corners in

Macomb  
 (County)


Located In: Washington Township  
 Corner Code #

- |                                    |             |              |                          |
|------------------------------------|-------------|--------------|--------------------------|
| 1. Public Land Survey              | T <u>4N</u> | R <u>12E</u> | Corner Code # <u>B-3</u> |
|                                    | T _____     | R _____      | _____                    |
|                                    | T _____     | R _____      | _____                    |
|                                    | T _____     | R _____      | _____                    |
| 2. Property Controlling in Section | S _____     | T _____      | R _____                  |
|                                    | S _____     | T _____      | R _____                  |
| 3. Miscellaneous Property in Sec.  | S _____     | T _____      | R _____                  |
|                                    | S _____     | T _____      | R _____                  |
4. Lot No. \_\_\_\_\_ Recorded Plat \_\_\_\_\_  
 5. Private Claims \_\_\_\_\_

**SURVEY & REMONUMENTATION**

OCT 19 1998

SECTION

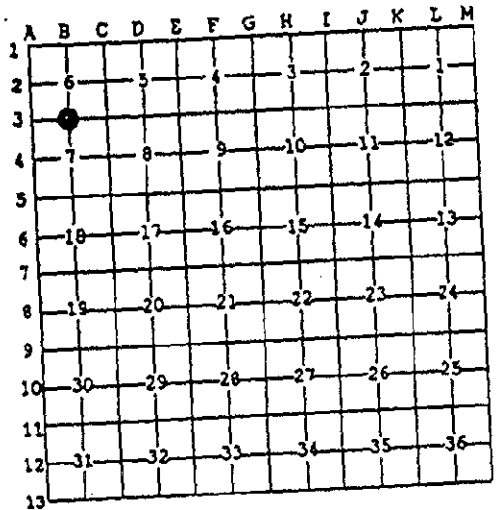

I, Huston K. Kennedy, in a field survey on February 9, 1998 do hereby state that under requirements of P.A. 74, Michigan P.A. of 1970, the corner points mentioned in lines 1 and 2 above were in conformance with regulations and rules therefore as required in the current manual of survey instructions of the United States Department of the Interior, Bureau of Land Management or by a decree of a Court of Law and/or that the corner points mentioned in lines 3, 4 and 5 above were in conformance with the rules of the Michigan Board of Land Surveyors or by a Decree of a Court of Law, established, re-established, monumented, recovered, found as expressed below.

NOTE: Not more than 2 corners, all in the same town and range, may be recorded on this certificate.

- A. Description of original monument and accessories and/or subsequent restoration:
- 1817-GLO Wampler, D.S.; Set Post 30" Elm N37°W 113 Links
  - 1972-Avey, PS #15396; LCRC L.2288, Pg.62 - Fnd 1/2" Bar
  - 1987-Kennedy, PS #17623; LCRC L.4286, Pg.342 - Fnd 1/2" Iron
  - 1995-King, PS #30085; LCRC L.6586, Pg.223 - Fnd 1/2" Iron
  - 1997-Wright, PS #40165; LCRC L.3705, Pg.72 - Fnd 1/2" Bar Bar
  - 1984-Kobs, PS #14097; Survey L.3705, Pg.72 - Fnd 1/2" Iron Bar
  - 1984-Kobs, PS #14097; Survey L.3705, Pg.88 - Fnd 1/2" Iron Bar, used same wit as 1984 Survey
  - 1997-Wright, PS #40165; Unrecorded Survey - Fnd 1/2" Bar, used same wit as 1997 LCRC

ACCEPTED BY THE MACOMB COUNTY SURVEY PEER GROUP AS THE OFFICIAL CORNER UNDER MICHIGAN PUBLIC ACT 345 OF 1990 AT A MEETING HELD ON 10/30/98  
William E. Soderberg  
 WILLIAM E. SODERBERG, P.S., CHAIRMAN

- B. Description of corner evidence found and/or method applied in restoring or reestablishing corner:  
 1998-Kennedy Surveying, Inc. - Kennedy, PS #17623 - Fnd a 1/2" Iron Rod 0.70 below the road surface and is located in the existing centerline of 31 Mile Road extending to the East & West, which has a gravel surface. Also in the existing centerline of Mt. Vernon Road extending to the South, which has a gravel surface. A fence line extending to the North.

Witnesses from LCRC #1, 2, 3 & Survey #4 were used to recover and verify the location of the found 1/2" Iron Rod.  
 I accepted the found 1/2" Iron Rod as the best evidence of the original corner position.

**FIELD MEASUREMENTS BETWEEN**

B-3 to A-3  
 GLO = 41.80 chains or 2758.80 Ft.  
 Surveys recorded in Liber 2723, page 882, in Liber 3705, page 72 = 2777.63 FL & 2777.66 FL (GPS-GROUND) & 2777.89 Ft. (EDM 1998)

B-3 to C-3  
 GLO = 40 chains or 2640.00 Ft.  
 Survey recorded in Liber 2723, page 862 = 2609.49 Ft.  
 Survey recorded in Liber 3186, page 699, in Liber 3579, page 121 = 2610.20 Ft. & 2609.70 Ft. (GPS-GROUND)  
 Unrecorded Survey by Jeffrey A. Wright, PS #40165 = 2609.69 Ft.

- C. Description of monument for corner and accessories established to perpetuate locating the position of the corner:  
 B-3 I replaced the found 1/2" Iron Rod with a 3/4" x 24" Iron Rod w/2" diameter aluminum cap stamped "Macomb County Monument Mi Act 345" #17623  
 S17°E 62.10' Set Mag Nail & Remon Washer SW face 10" Maple  
 S48°W 44.53' Set Mag Nail & Remon Washer NW face 19" Walnut  
 S46°E 69.90' Set Mag Nail & Remon Washer SW face 28" Twin Oak  
 N53°W 42.51' Set Mag Nail & Remon Washer SW face Power Pole

The selected location is accepted by me and is generally accepted by Professional Surveyors as the best available evidence of the position of the original corner.

Signed by: [Signature]  
 Surveyor's Michigan License No. 17023

Date 7-2-98

