

LAND CORNER RECORDATION CERTIFICATE
Filing Requirement of Act 74, Mich. P.A. 1970

For corners in

Macomb
(County)

Located In: Washington Township Corner Code # C-5

- | | | | |
|------------------------------------|-------------|--------------|-----|
| 1. Public Land Survey | T <u>4N</u> | R <u>12E</u> | C-5 |
| | T | R | |
| | T | R | |
| | T | R | |
| 2. Property Controlling in Section | S | T | R |
| | S | T | R |
| 3. Miscellaneous Property in Sec. | S | T | R |
| | S | T | R |

SURVEY & REMONUMENTATION

OCT 19 1998


SECTION

Register of Deeds Stamp & File Number

4. Lot No. _____ Recorded Plat _____
5. Private Claims _____

C0738447 LIBER:08156 PAGE:811 09:45A 07/20/1998
CARMELLA SABAUGH-MACOMB COUNTY, MI REG/DEEDS

I, Huston K. Kennedy, in a field survey on March 12, 1998 do hereby state that under requirements of P.A. 74, Michigan P.A. of 1970, the corner points mentioned in lines 1 and 2 above were in conformance with regulations and rules therefore as required in the current manual of survey instructions of the United States Department of the Interior, Bureau of Land Management or by a decree of a Court of Law and/or that the corner points mentioned in lines 3, 4 and 5 above were in conformance with the rules of the Michigan Board of Land Surveyors or by a Decree of a Court of Law, established, re-established, monumented, recovered, found as expressed below:

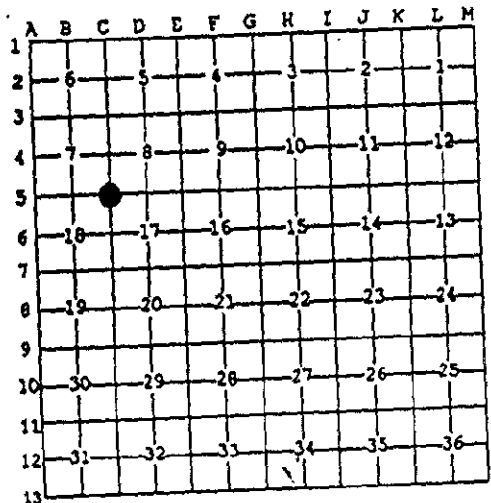

NOTE: Not more than 2 corners, all in the same town and range, may be recorded on this certificate.

- A. Description of original monument and accessories and/or subsequent restoration:
1817-GLO Wampler, D.S.; Set Post 10" White Oak S70°E 19 Links; 18" White Oak S80°W 88 Links
1.) 1972-Kobs, PS #14097; LCRC L.2302, Pg.184 - Fnd 1/2" Iron Bar
2.) 1972-Kobs, PS #14097; Survey L.2302, Pg.153 - Fnd 1/2" Iron Bar, used same wit as 1972 LCRC
- B. Description of corner evidence found and/or method applied in restoring or reestablishing corner:
1998-Kennedy Surveying, Inc. - Kennedy, PS #17623 - Fnd a 3/8" Iron Rod 0.30 feet above the surface at the base of an old wooden and steel fence corner. A fence line extending to the East & West.

Witnesses from LCRC #1 were used to recover and verify the location of the found 1/2" Iron Bar.

I accepted the found 1/2" Iron Bar as the best evidence of the original corner position.

ACCEPTED BY THE MACOMB COUNTY SURVEY PEER GROUP AS THE OFFICIAL CORNER UNDER MICHIGAN PUBLIC ACT 345 OF 1990 AT A MEETING HELD ON 6/30/98

FIELD MEASUREMENTS BETWEEN

C-5 to C-4
GLO = 40 chains or 2640.00 FL
From drawing (sources unknown) = 2704.19 FL
2674.79 FL. (GPS-GROUND)

C-5 to B-5
GLO = 40 chains or 2640.00 FL
2620.57 FL. (GPS-GROUND)

C-5 to C-6
GLO = 40 chains or 2640.00 FL
Survey recorded in Liber 2302, page 153 = 2701.77 FL
2701.46 FL. (GPS-GROUND)

C-5 to D-5
GLO = 40.43 chains or 2668.38 FL
Survey recorded in Liber 2302, page 153 = 2780.55 FL
2780.55 FL. (GPS-GROUND)

- C. Description of monument for corner and accessories established to perpetuate locating the position of the corner:
C-5 I replaced the found 3/8" Iron Bar with a 4" diameter Concrete Monument with 1/2" Iron Rod 36" long w/2" diameter aluminum cap stamped "Macomb County Monument, MI Act #345" #17623
S54°E 28.62' Set Mag Nail & Remon Washer SW face 10" Maple
S83°W 19.60' Set Mag Nail & Remon Washer North face 13" Elm
Due East 11.41' Set Mag Nail & Remon Washer North face 7" Oak
N47°W 26.51' Set Mag Nail & Remon Washer SW face 10" Elm

The selected location is accepted by me and is generally accepted by Professional Surveyors as the best evidence of the position of the original corner.

Signed by: [Signature]
Surveyor's Michigan License No. 17623

Date 7-2-98

