

**LAND CORNER RECORDATION CERTIFICATE**  
 Filing Requirement of Act 74, Mich. P.A. 1970

For corners in

<u>Macomb</u> (County)	Located In:	Corner Code #
	Washington Township	
1. Public Land Survey	T <u>4N</u>	R <u>12E</u> <u>C-10</u>
	T _____	R _____
	T _____	R _____
	T _____	R _____
2. Property Controlling in Section	S _____	T _____ R _____
	S _____	T _____ R _____
3. Miscellaneous Property in Sec.	S _____	T _____ R _____
	S _____	T _____ R _____

Register of Deeds Stamp & File Number

4. Lot No. \_\_\_\_\_, Recorded Plat \_\_\_\_\_  
 5. Private Claims \_\_\_\_\_

I, Huston K. Kennedy, in a field survey on April 15, 1999 do hereby state that under requirements of P.A. 74, Michigan P.A. of 1970, the corner points mentioned in lines 1 and 2 above were in conformance with regulations and rules therefore as required in the current manual of survey instructions of the United States Department of the Interior, Bureau of Land Management or by a decree of a Court of Law and/or that the corner points mentioned in lines 3, 4 and 5 above were in conformance with the rules of the Michigan Board of Land Surveyors or by a Decree of a Court of Law, established, re-established, monumented, recovered, found as expressed below:

**NOTE:** Not more than 2 corners, all in the same town and range, may be recorded on this certificate.

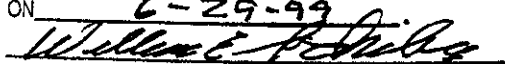
	A	B	C	D	E	F	G	H	I	J	K	L	M
1													
2	6		5		4		3		2		1		
3													
4	7		8		9		10		11		12		
5													
6	18		17		16		15		14		13		
7													
8	19		20		21		22		23		24		
9													
10	30		29		28		27		26		25		
11													
12	31		32		33		34		35		36		
13													

- A. Description of original monument and accessories and/or subsequent restoration:  
 1817-GLO Wampler, D.S.; Set Post 12" Sugar Tree N68°E 6 Links; 12" Ash N73°W 20 Links  
 "EYSTER'S MT. VERNON FARMS" Liber 23, Page 22
- B. Description of corner evidence found and/or method applied in restoring or reestablishing corner:  
 1999-Kennedy Surveying, Inc. - Kennedy, PS #17623 - Fnd a 4" diameter Concrete Monument with a 1/2" Iron Pipe 80 feet West of the West edge of Stoney Creek Lake. A old fence row extends to the North, South & West. The East 1/4 corner of Section 30 is the Southeast corner of Lot 12 of "EYSTER'S MT. VERNON FARMS".

**FIELD MEASUREMENTS BETWEEN**

**C-10 to C-9**  
 GLO = 40 chains or 2640.00 Ft.  
 "EYSTER'S MT. VERNON FARMS" = 2641.30 Ft.  
 2643.78 Ft. (MEA 1999)

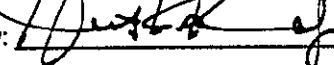
**C-10 to C-11**  
 GLO = 40 chains or 2640.00 Ft.  
 No recorded distances  
 2633.06 Ft. (MEA 1999)

ACCEPTED BY THE MACOMB COUNTY SURVEY PEER GROUP AS THE OFFICIAL CORNER UNDER MICHIGAN PUBLIC ACT 345 OF 1990 AT A MEETING HELD ON 6-29-99  
  
 WILLIAM E. SODERBERG, P.S., CHAIRMAN



- C. Description of monument for corner and accessories established to perpetuate locating the position of the corner:  
 C-10 I accepted the found 4" diameter Concrete Monument with a 1/2" Iron Pipe and placed a 2" diameter aluminum cap stamped "Macomb County Monument, MI Act #345", PS #17623  
 S22°E 37.40' Set Mag Nail & Remon Washer NE face 10" Willow  
 N86°E 7.45' Set Mag Nail & Remon Washer South face 7" Elm  
 N17°E 42.28' Set Mag Nail & Remon Washer SE face 10" Elm  
 N84°W 24.80' Set Mag Nail & Remon Washer North face 6" Elm

The selected location is accepted by me and is generally accepted by Professional Surveyors as the best available evidence of the position of the original corner.

Signed by:   
 Surveyor's Michigan License No. 17623

Date 7-29-99

905