

LAND CORNER RECORDATION CERTIFICATE
 Filing Requirement of Act 74, Mich. P.A. 1970

For corners in

Macomb
 (County)

Located in: Washington Township Corner Code #


1. Public Land Survey	T <u>4N</u>	R <u>12E</u>	<u>C-11</u>
	T _____	R _____	_____
	T _____	R _____	_____
	T _____	R _____	_____
2. Property Controlling in Section	S _____	T _____	R _____
	S _____	T _____	R _____
3. Miscellaneous Property in Sec.	S _____	T _____	R _____
	S _____	T _____	R _____

4. Lot No. _____ Recorded Plat _____
 5. Private Claims _____

WILLIAM E. SODERBERG, P.S., CHAIRMAN
 ACCEPTED BY THE MACOMB COUNTY SURVEY BOARD
 GROUP AS THE OFFICIAL CORNER UNDER MICHIGAN
 PUBLIC ACT 345 OF 1990 AT A MEETING HELD
 ON 6-12-8
 Register of Deeds Stamp & File Number

I, Huston K. Kennedy, in a field survey on April 15, 1999 do hereby state that under requirements of P.A. 74, Michigan P.A. of 1970, the corner points mentioned in lines 1 and 2 above were in conformance with regulations and rules therefore as required in the current manual of survey instructions of the United States Department of the Interior, Bureau of Land Management or by a decree of a Court of Law and/or that the corner points mentioned in lines 3, 4 and 5 above were in conformance with the rules of the Michigan Board of Land Surveyors or by a Decree of a Court of Law; established, re-established, monumented, recovered, found as expressed below:

NOTE: Not more than 2 corners, all in the same town and range, may be recorded on this certificate.

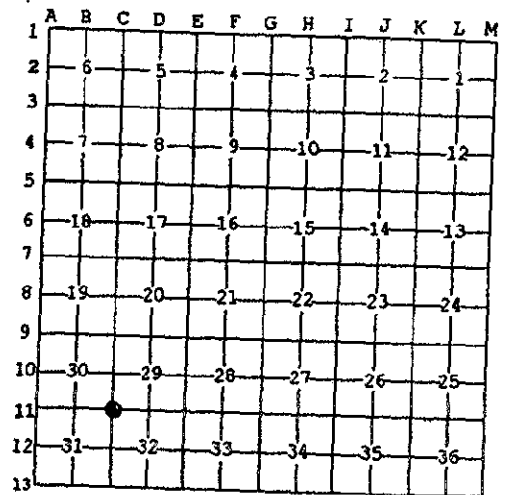

- A. Description of original monument and accessories and/or subsequent restoration:
 1817-GLO Wampler, D.S.; Set Post 20" Black Oak East 8 Links; 26" White Oak West 67 Links
- B. Description of corner evidence found and/or method applied in restoring or reestablishing corner:
 1999-Kennedy Surveying, Inc. - Kennedy, PS #17623 - The corner as recovered is located in Stoney Creek Park North Dale Picnic Area Parking Lot and 42 feet West of the East edge of bituminous surface, and 27 feet East of the West edge of bituminous surface.

HOW THE CORNER WAS RECOVERED

The corner was recovered at the intersection of the North line of Section 32 per "LOCKWOOD HILLS SUBDIVISION" and the straight line between C-10 to C-13.

FIELD MEASUREMENTS BETWEEN

C-11 to C-10
 GLO = 40 chains or 2640.00 Ft.
 No recorded distances
 2633.06 Ft. (MEA 1999)

C-11 to D-11
 GLO = 40.34 chains or 2662.44 Ft.
 No recorded distances
 2712.54 Ft. (MEA 1999)

C-11 to C-12
 GLO = 40 chains or 2640.00 Ft.
 No recorded distances
 2646.14 Ft. (MEA 1999)

- C. Description of monument for corner and accessories established to perpetuate locating the position of the corner:
 C-11 | set a 3/4" x 24" Iron Rod w/2" diameter aluminum cap stamped "Macomb County Monument"
 S63°E 58.38' Set Mag Nail & Remon Washer NE face 12" Oak
 S47°W 67.50' Set Mag Nail & Remon Washer SE face 12" Oak
 N86°E 51.11' Set Mag Nail & Remon Washer North face 12" Oak
 N81°W 43.90' Set Mag Nail & Remon Washer South face 18" Oak



The selected location is accepted by me and is generally accepted by Professional Surveyors as the best available evidence of the position of the original corner.

Signed by: [Signature] Date 9-3-99
 Surveyor's Michigan License No. 17623

AD6